CONSTRUCTION PLANS

Sta.2042+00.00 To Sta.2136+00.00
PROJECT N22(6A)2&4

Sta.2136+00.00 To Sta.2394+86.77
PROJECT N22(6B)

STATE ROUTE 98 FROM MP 302.00 TO MP 361.00 DESIGNATED AS A SCENIC ROAD PER RESOLUTION 2005-01-C-007. DOC. 2005-02410 RECORDED 01/31/2005 N.C.R. PLAN MAINT.: GMTS CORP. 6-16-10

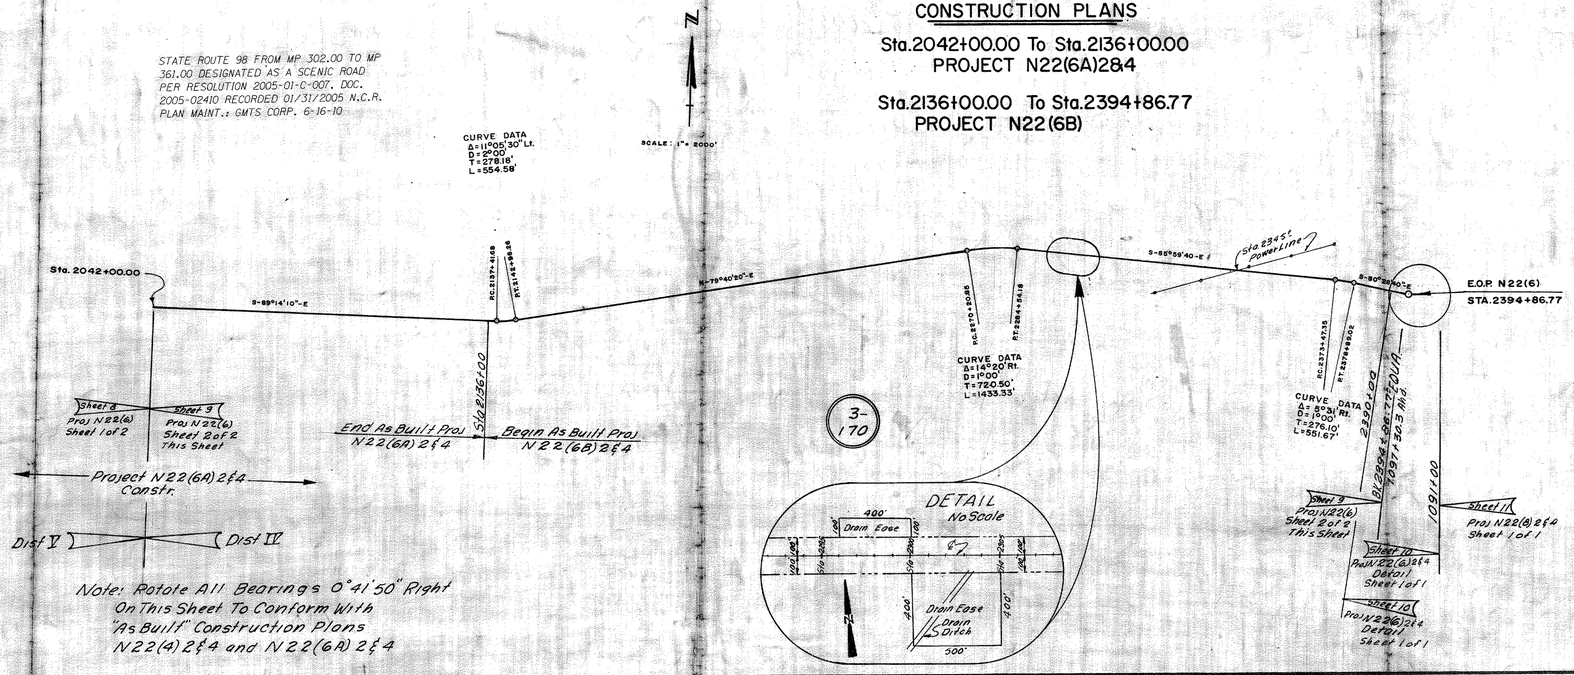

Note: Rotate All Bearings 0°41'50" Right
On This Sheet To Conform With
"As Built" Construction Plans
N22(4) 2&4 and N22(6A) 2&4

Arizona State Route 98
ADOT Project No. S-559-601
ADOT Right of Way Map No. B-3-T-606
Sheet No. 9 of 14

Sheet No. 2 of 2

Click here for SR 98 Index

Map No. B-3-T-606 Sheet 9 of 14