BENSON-MAMMOTH HWY.
SAN PEDRO RIVER BRIDGE #1372
PIMA COUNTY

Click here for SR 76 Index

REVISIONS				
6117 6261	12-29-82 10-18-83	HM M. L B	No Rev's Necessary Bid - 303 Rev. Drain. Easement to R/W	

PROJECT NO.	S-358-903
DRAWING NO.	D-10-T-340
SHEET NO.	1 of 1
DRAWN BY	L. W. B.
DATE COMP.	10-7-82
SCALE	1" = 100'

OWNERSHIP RECORD										ACQUISITION RECORD				
PARCEL NUMBER	OWNER	DESCRIPTION	TOTAL AREA	AREA REQUIRED GROSS INCLUDING EXISTING R/W	AREA REQUIRED NET EXCLUDING EXISTING R/W	EASEMENT AREA	REMAINDER LEFT	REMAINDER RIGHT	SHEET NUMBER	BOARD APPROVAL	TYPE & DATE OF INSTRUMENT	RECORDED DATE	RECORDED BOOK	RECORDED PAGE
10-459	Bayless & Berkalew Co.	Pt. E 1/2 SE1/4, Sec. 27, T. 11 S., R. 18 E.	307.9Ac.		0.9 Ac.	0.9Ac.	257 Ac.	50 Ac.	1	1-11-83	~~Right of Entry~~	~~12-17-82~~		
										10-6-83	W.D. 3-24-83	10-14-83	7137	728-729

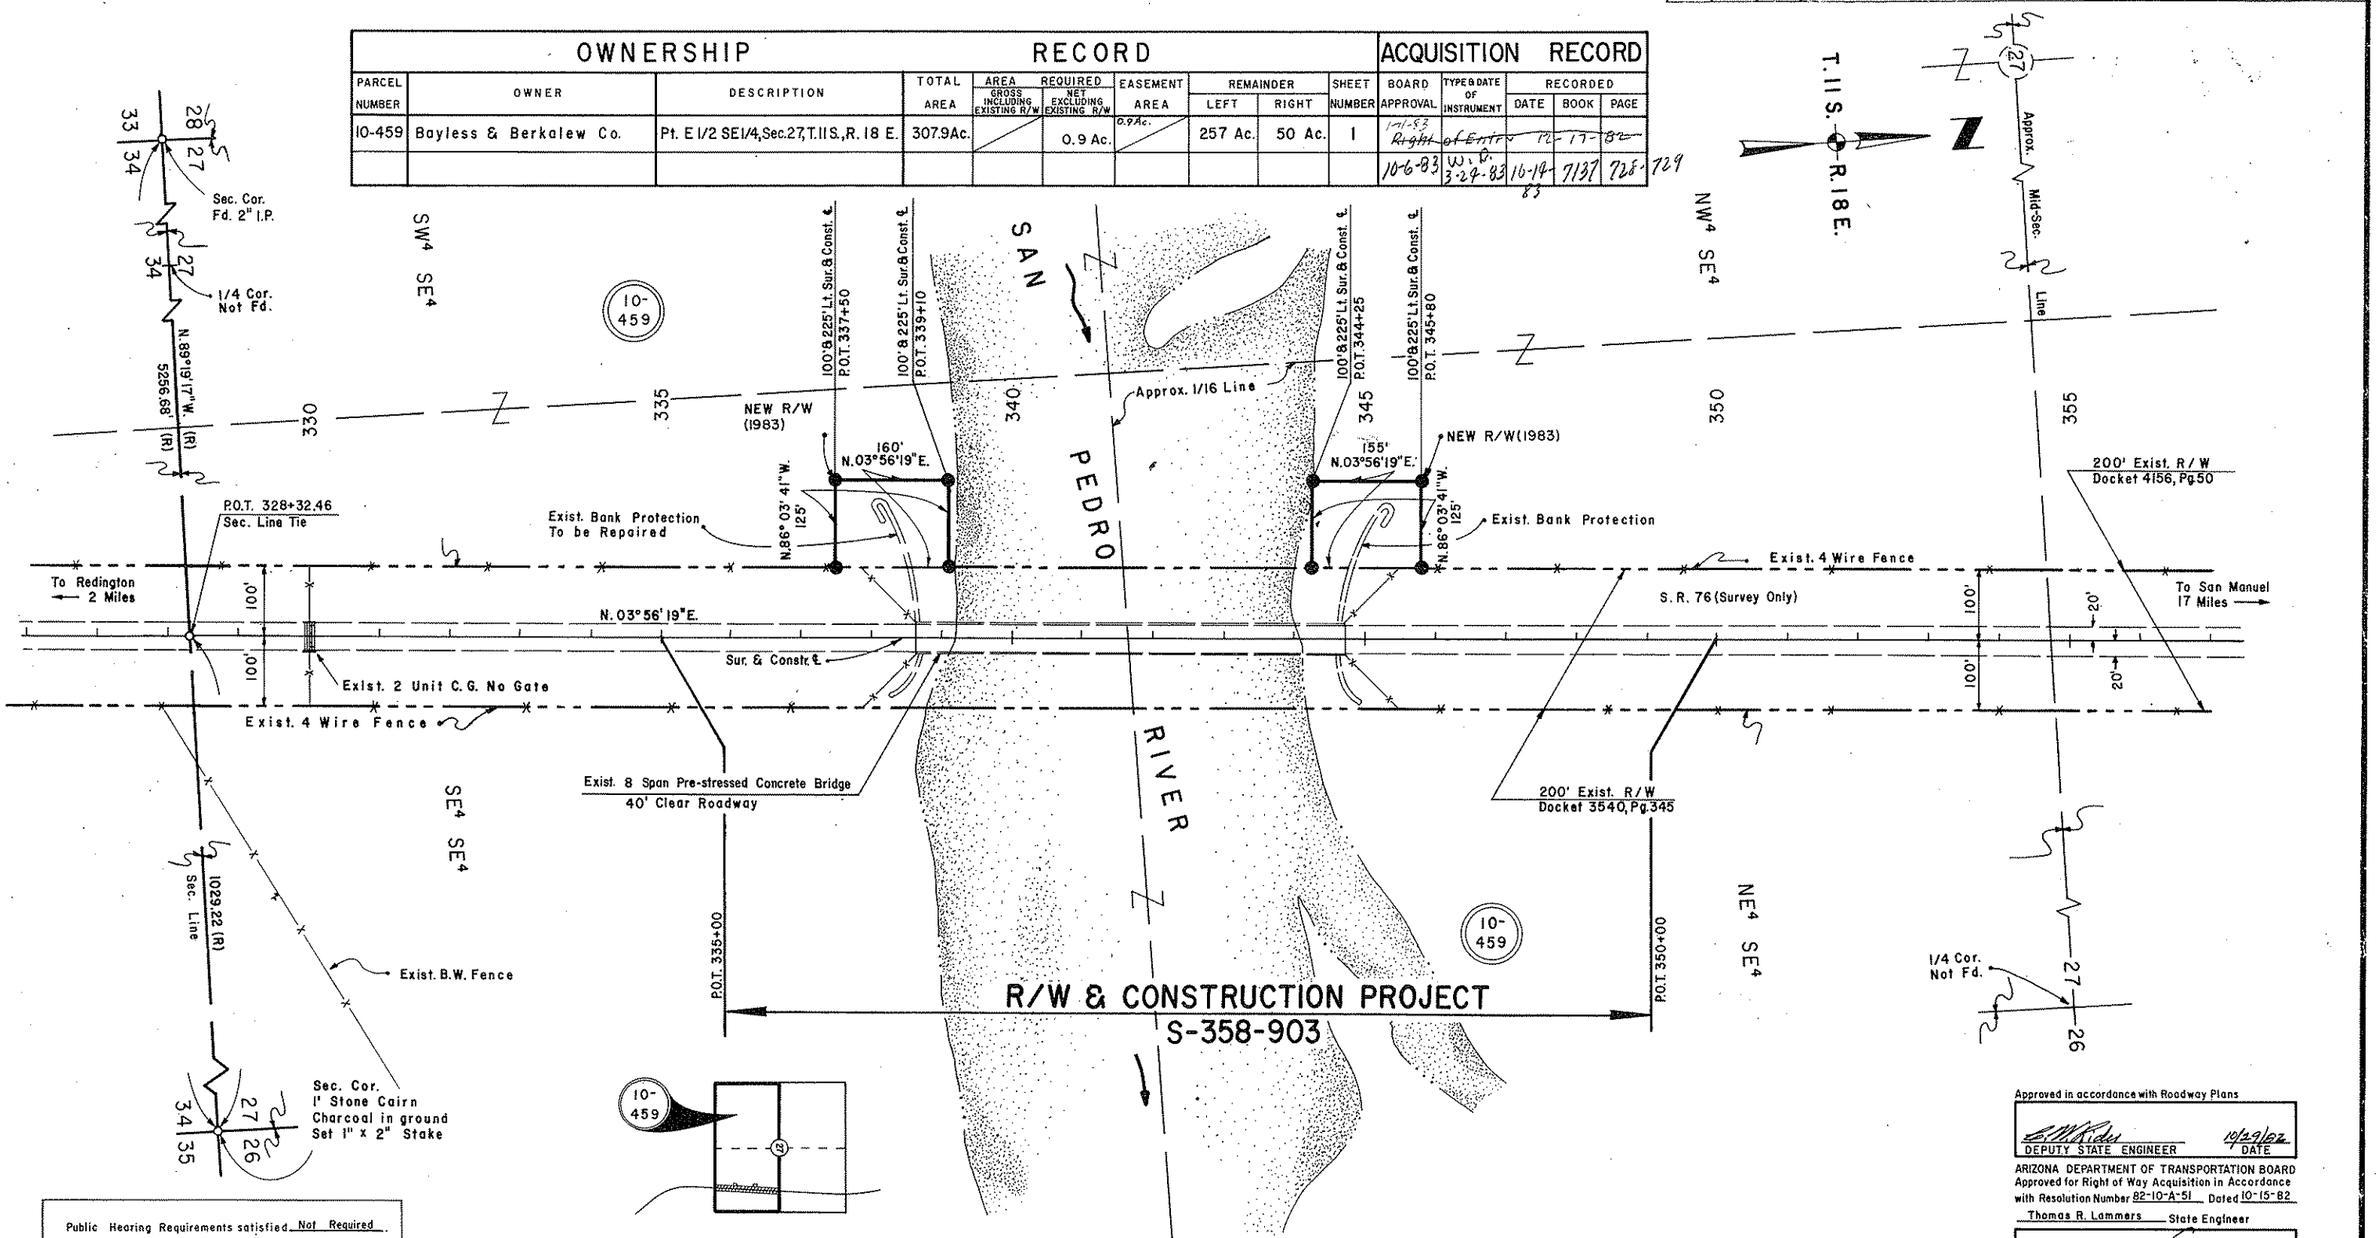

Public Hearing Requirements satisfied Not Required.
Environmental Impact Statement Requirements satisfied 10-5-82.

Approved in accordance with Roadway Plans
DEPUTY STATE ENGINEER — DATE 10/29/82

ARIZONA DEPARTMENT OF TRANSPORTATION BOARD
Approved for Right of Way Acquisition in Accordance with Resolution Number 82-10-A-51 Dated 10-15-82
Thomas R. Lammers State Engineer
CHIEF DEPUTY STATE ENGINEER — DATE 10-29-82

CHECKED BY
HARD COPY SEE S-358-701