F.H.W.A. REGION	STATE	PROJECT NO.	SHEET NO.	TOTAL SHEETS	FINALIZED PLANS
9	ARIZ.	S-249-813	1	12	

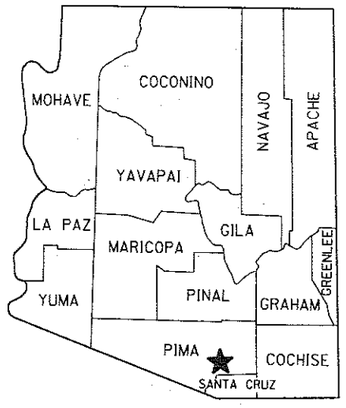

STATE OF ARIZONA
DEPARTMENT OF TRANSPORTATION

HIGHWAYS DIVISION
RIGHT OF WAY PLAN OF THE
PARKER CANYON LAKE - MOUNTAIN VIEW HWY.
CORONADO NATIONAL FOREST SECTION
(S.R. 83)

PROJECT NO. S-249-813

PIMA COUNTY — DISTRICT 2

LENGTH OF PROJECT — 7.35 Miles

File Set

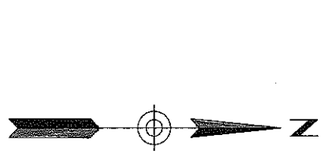

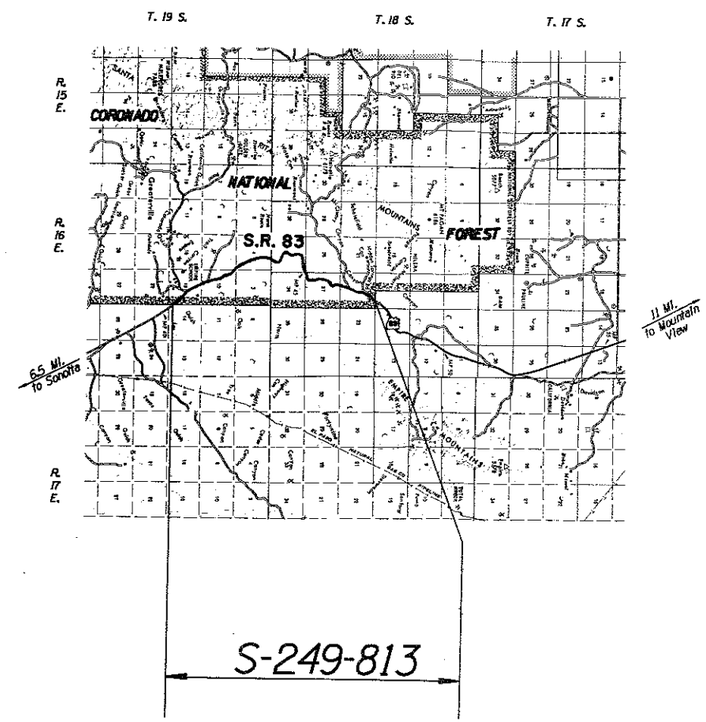

NOTE: These plans are prepared from a "best fit" alignment derived from as built plans, S-249(4), Non F.A.S. 249 (1956) and hard copy 8709 MI-M7, and are for the express purpose of acquiring rights of way from the Coronado National Forest.

James P. Oley — 12-2-87
DEPUTY STATE ENGINEER — DATE

ARIZONA DEPARTMENT OF TRANSPORTATION BOARD
APPROVED FOR RIGHT OF WAY ACQUISITION IN ACCORDANCE WITH RESOLUTION 59-19, R56-5
D. W. FORD — STATE ENGINEER

A. J. Judd — 12-8-87
CHIEF DEPUTY STATE ENGINEER — DATE

U. S. DEPARTMENT OF TRANSPORTATION
FEDERAL HIGHWAY ADMINISTRATION

DIVISION ADMINISTRATOR — DATE

DRAWING NUMBER	D - 10 - T - 355

Click here for SR 83 Index

Click here for SR 83 Index

CHECKED BY

OWNERSHIP RECORD										ACQUISITION RECORD				
PARCEL NUMBER	OWNER	DESCRIPTION	TOTAL AREA	AREA REQUIRED GROSS INCLUDING EXISTING R/W	AREA REQUIRED NET EXCLUDING EXISTING R/W	EASEMENT AREA	REMAINDER LEFT	REMAINDER RIGHT	SHEET NUMBER	BOARD APPROVAL	TYPE & DATE OF INSTRUMENT	RECORDED DATE	RECORDED BOOK	RECORDED PAGE
10-746	U.S.A. (Coronado National Forest)	Pt. of Sec. 22, 27, 28, 33 & 34, T18S, R16E; Pt. of Sec. 3, 4, 9, 10 & 15, T19S, R16E			150.2 AC.				4 THRU 12					

REDUCED SIZE DO NOT SCALE

REVISIONS			
C.O. NO.	DATE	BY	DESCRIPTION
7559	10-25-87	H.E.	ADDED THIS SHEET.

DRAWING NO.	D-10-T-355
HARD COPY	8709 MI-M7
COUNTY	PIMA
DRAWN	GREINER/SEPT. '87
CHECKED	HE/OCT. '87
SCALE	
ROUTE	S.R.83
LOCATION	CORONADO NATIONAL FOREST SECTION

ARIZONA DEPARTMENT OF TRANSPORTATION
HIGHWAYS DIVISION
RIGHT OF WAY PLANS SERVICES

HIGHWAY: PARKER CANYON LAKE-MT. VIEW

PROJECT NO. S-249-813

REGISTERED LAND SURVEYOR — CERTIFICATE NO. 15089 — JAMES R. CRISTEA — ARIZONA, U.S.A.

SHEET 2 OF 12

___ OF ___

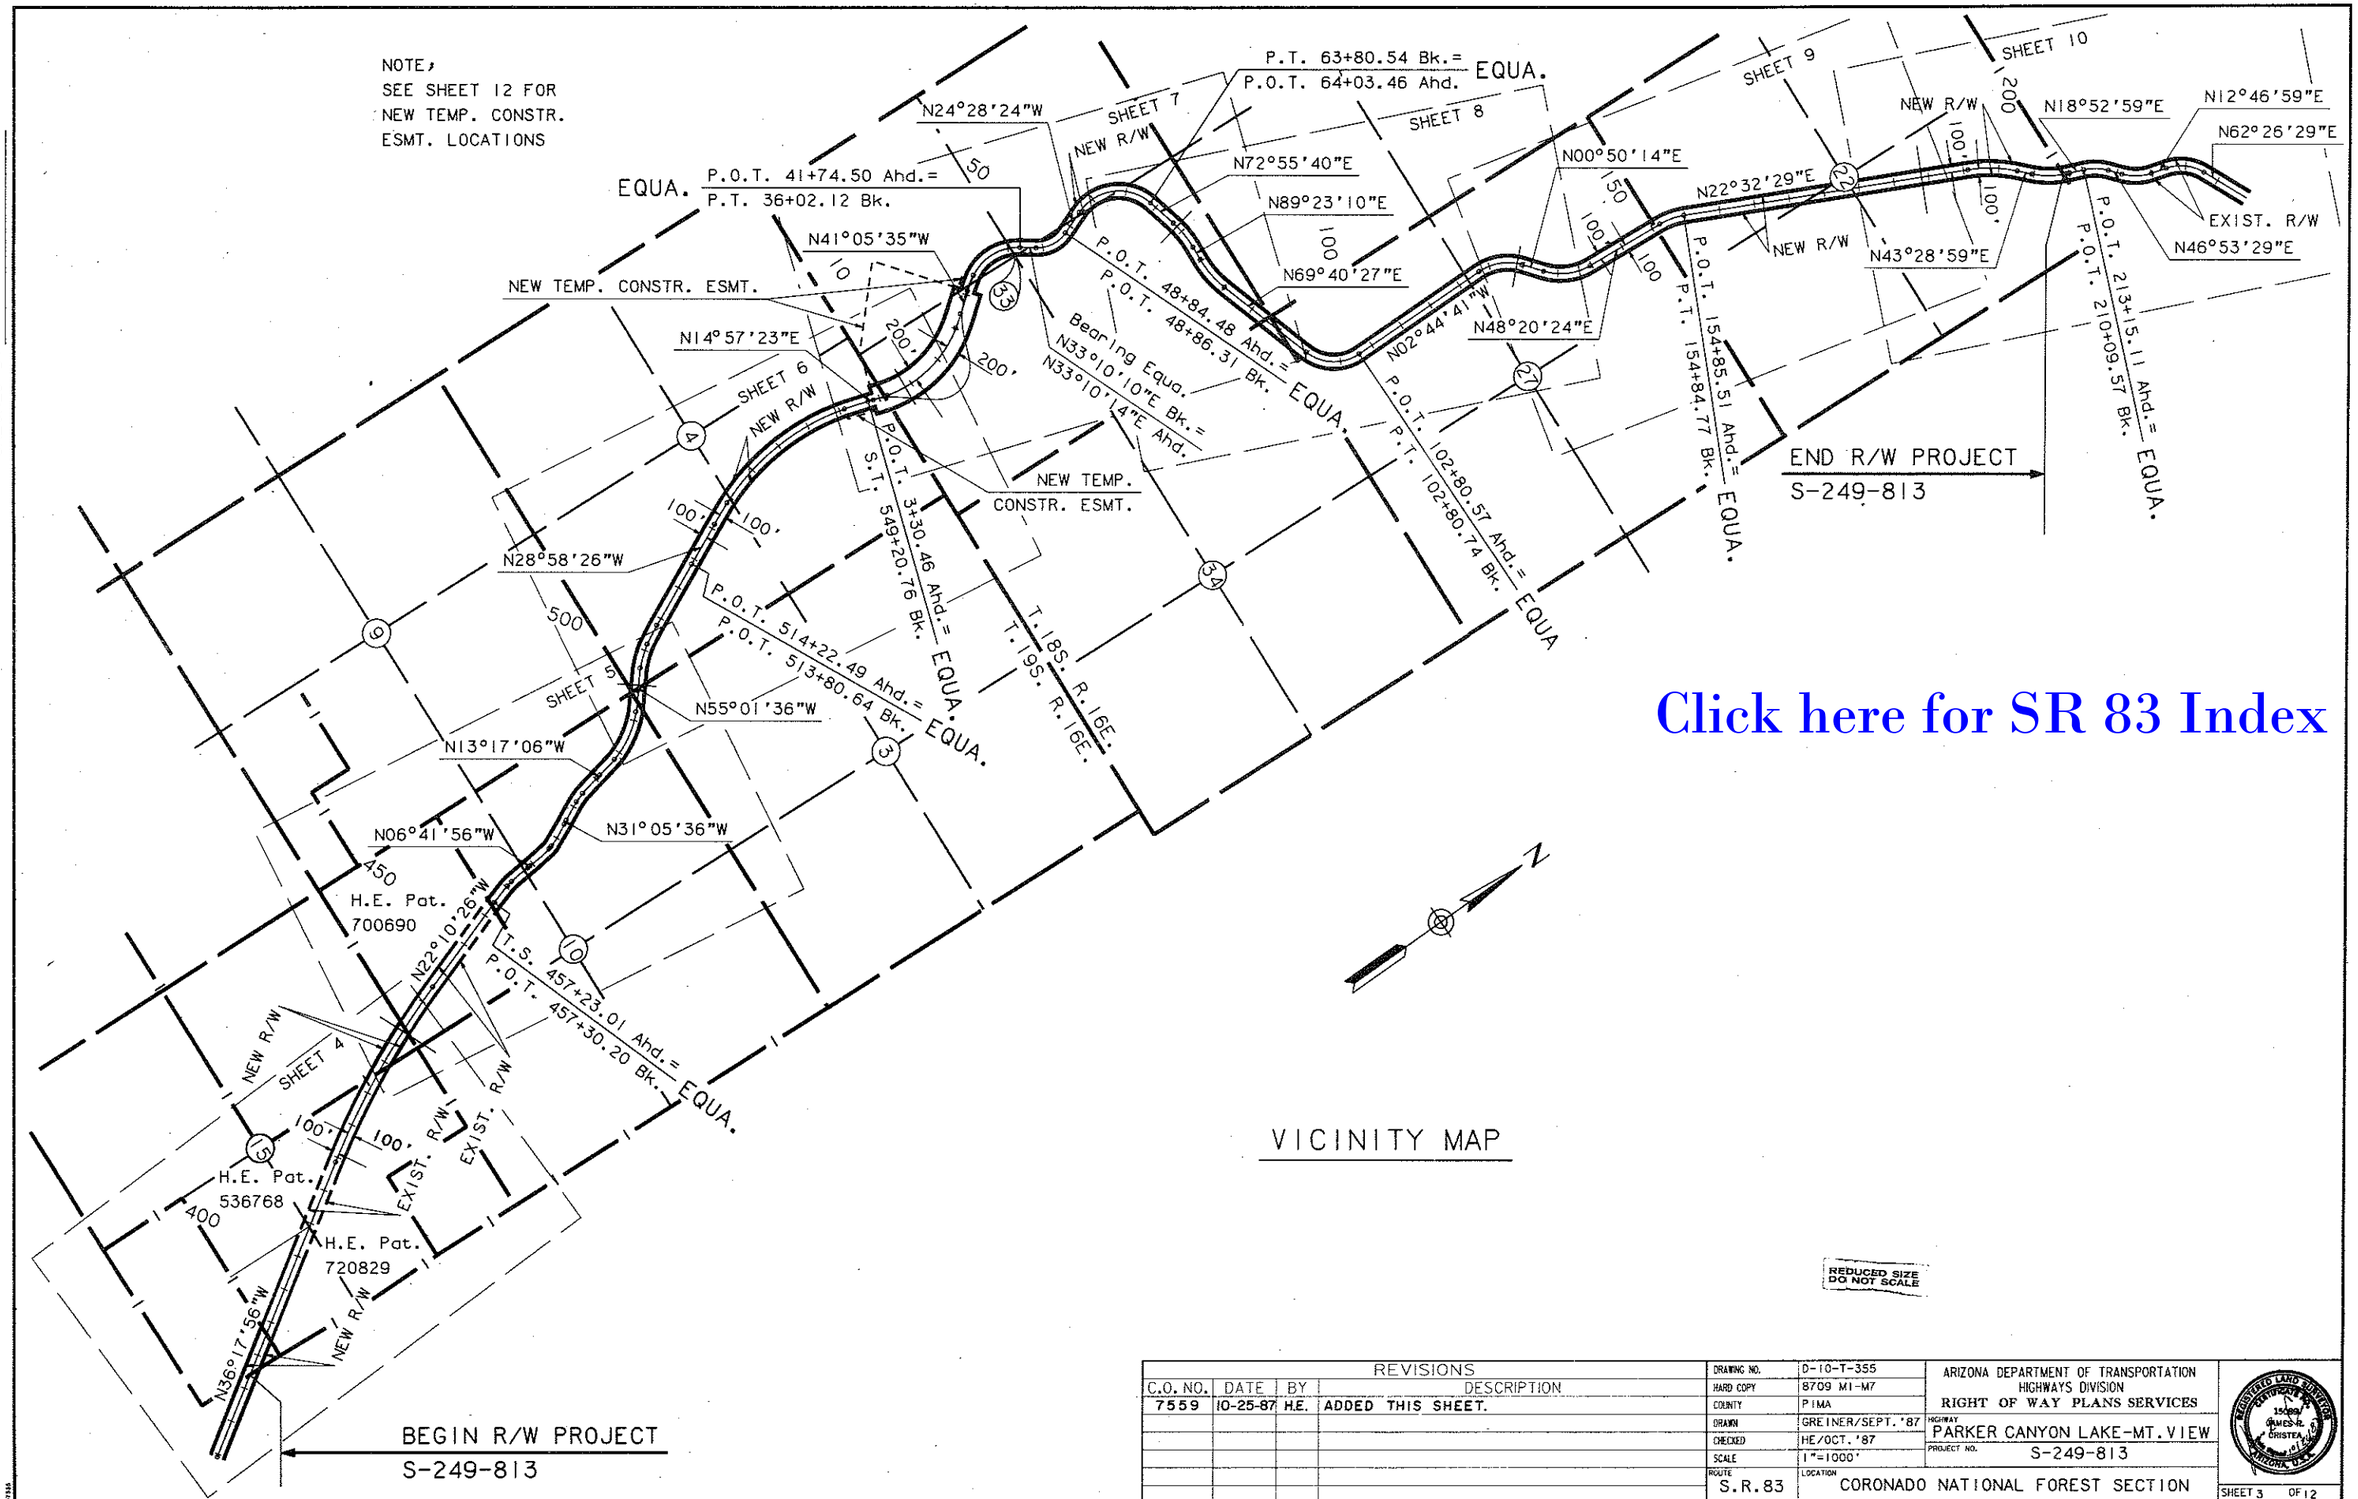

Click here for SR 83 Index

VICINITY MAP

REDUCED SIZE
DO NOT SCALE

REVISIONS			
C.O. NO.	DATE	BY	DESCRIPTION
7559	10-25-87	H.E.	ADDED THIS SHEET.

DRAWING NO.	D-10-T-355
HARD COPY	8709 M1-M7
COUNTY	PIMA
DRAWN	GREINER/SEPT. '87
CHECKED	HE/OCT. '87
SCALE	1"=1000'
ROUTE	S.R.83
LOCATION	CORONADO NATIONAL FOREST SECTION

ARIZONA DEPARTMENT OF TRANSPORTATION
HIGHWAYS DIVISION
RIGHT OF WAY PLANS SERVICES

HIGHWAY: PARKER CANYON LAKE-MT. VIEW
PROJECT NO. S-249-813

SHEET 3 OF 12

CHECKED BY

___ OF ___

Click here for SR 83 Index

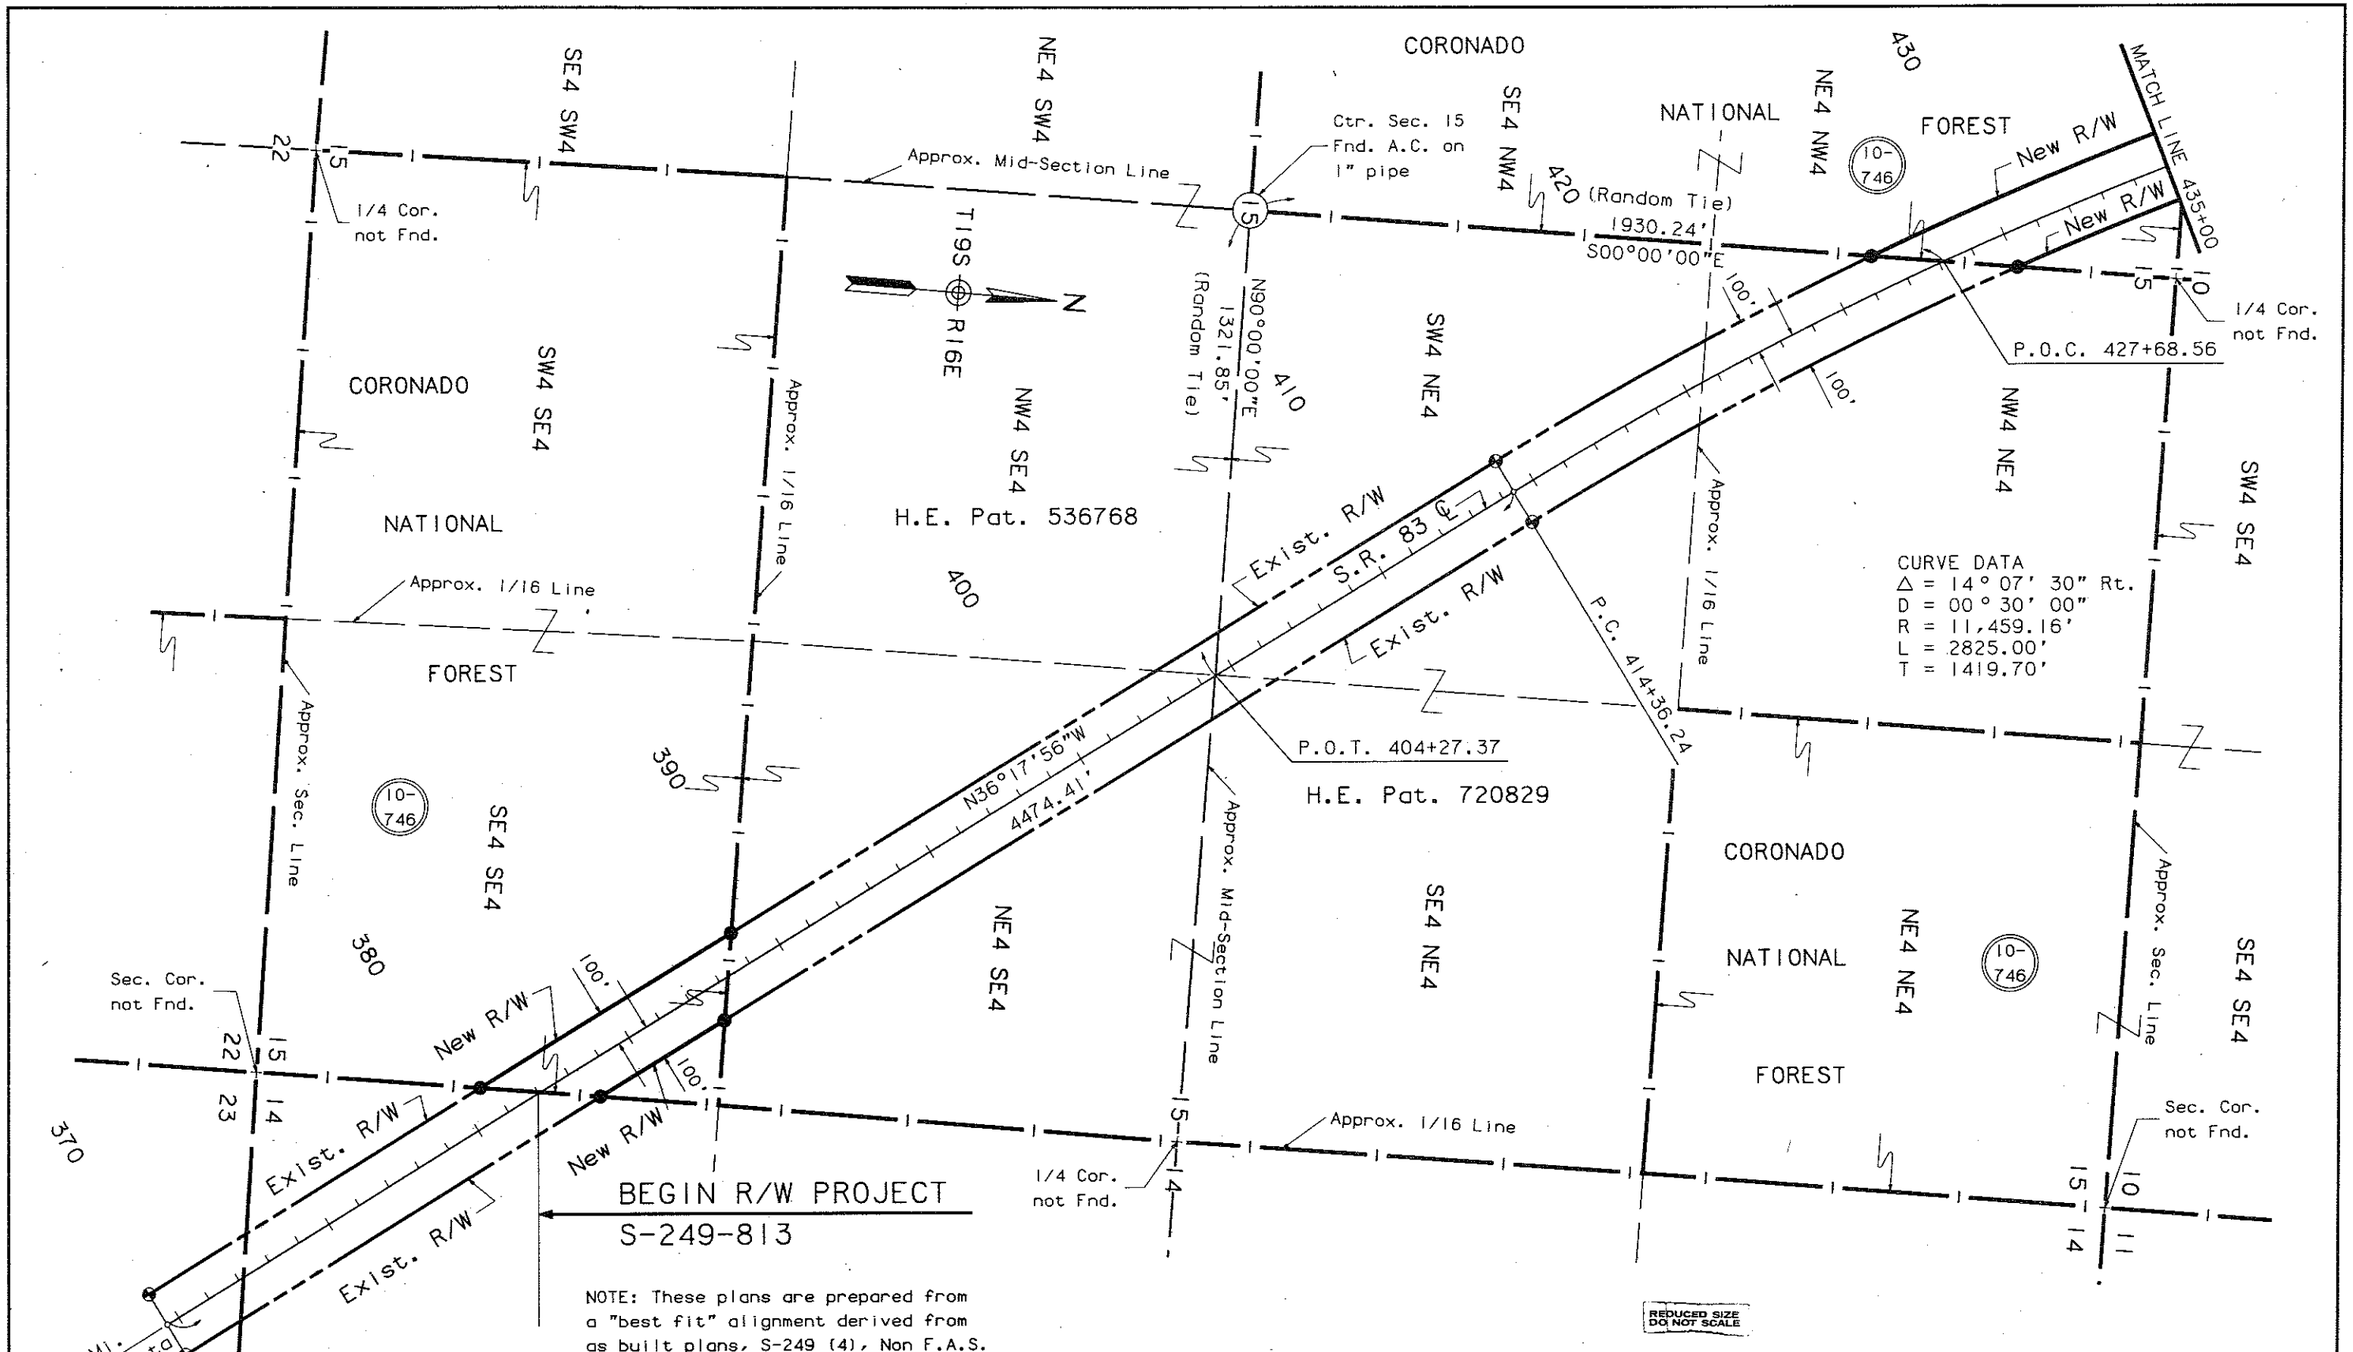

NOTE: These plans are prepared from a "best fit" alignment derived from as built plans, S-249 (4), Non F.A.S. 249 (1956) and hard copy 8709 MI-M7, and are for the express purpose of acquiring rights of way from the Coronado National Forest.

REVISIONS			
C.O. NO.	DATE	BY	DESCRIPTION
7559	10-25-87	H.E.	ADDED THIS SHEET.

DRAWING NO.	D-10-T-355
HARD COPY	8709 MI-M7
COUNTY	PIMA
DRAWN	GREINER/SEPT. '87
CHECKED	HE/OCT. '87
SCALE	1"=200'
ROUTE	S.R.83

ARIZONA DEPARTMENT OF TRANSPORTATION
HIGHWAYS DIVISION
RIGHT OF WAY PLANS SERVICES

HIGHWAY: PARKER CANYON LAKE-MT. VIEW
PROJECT NO. S-249-813
LOCATION: CORONADO NATIONAL FOREST SECTION

SHEET 4 OF 12

CHECKED BY _____ OF _____

Click here for SR 83 Index

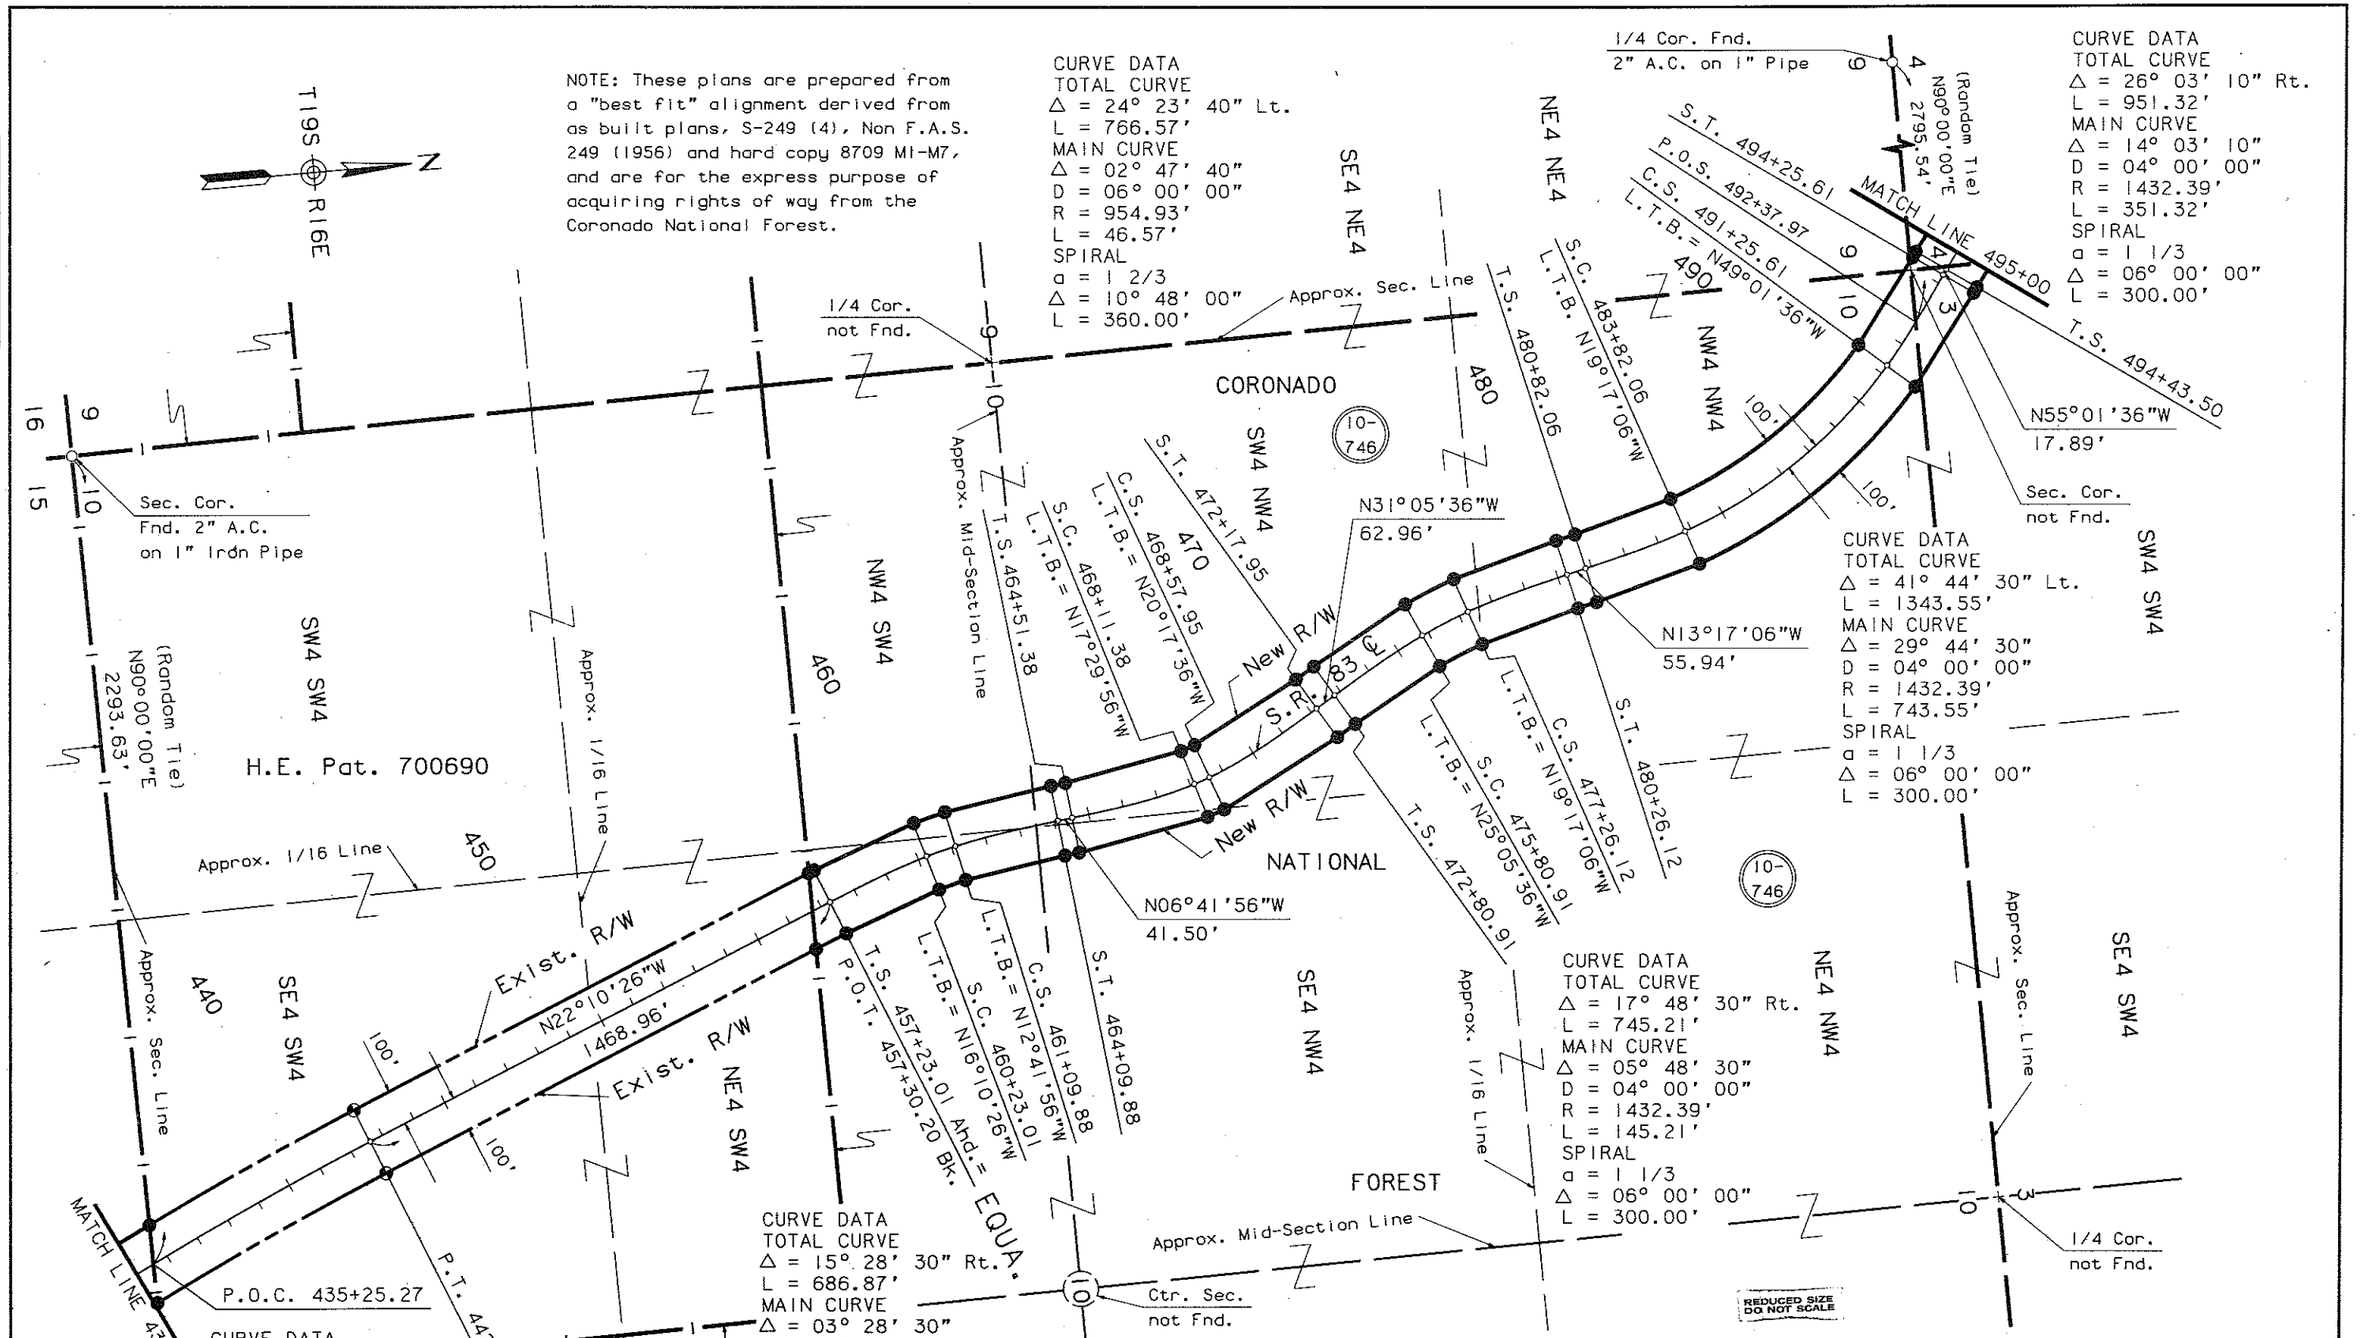

CHECKED BY

REVISIONS			
C.O. NO.	DATE	BY	DESCRIPTION
7559	10-25-87	H.E.	ADDED THIS SHEET.

DRAWING NO.	D-10-T-355
HARD COPY	8709 MI-M7
COUNTY	PIMA
DRAWN	GREINER/SEPT. '87
CHECKED	HE/OCT. '87
SCALE	1"=200'
ROUTE	S.R.83

ARIZONA DEPARTMENT OF TRANSPORTATION
HIGHWAYS DIVISION
RIGHT OF WAY PLANS SERVICES

HIGHWAY: PARKER CANYON LAKE-MT. VIEW
PROJECT NO. S-249-813
LOCATION: CORONADO NATIONAL FOREST SECTION

REGISTERED LAND SURVEYOR CERTIFICATE NO. 15089 JAMES T. CRISTEA ARIZONA, U.S.A.

SHEET 5 OF 12

OF

Click here for SR 83 Index

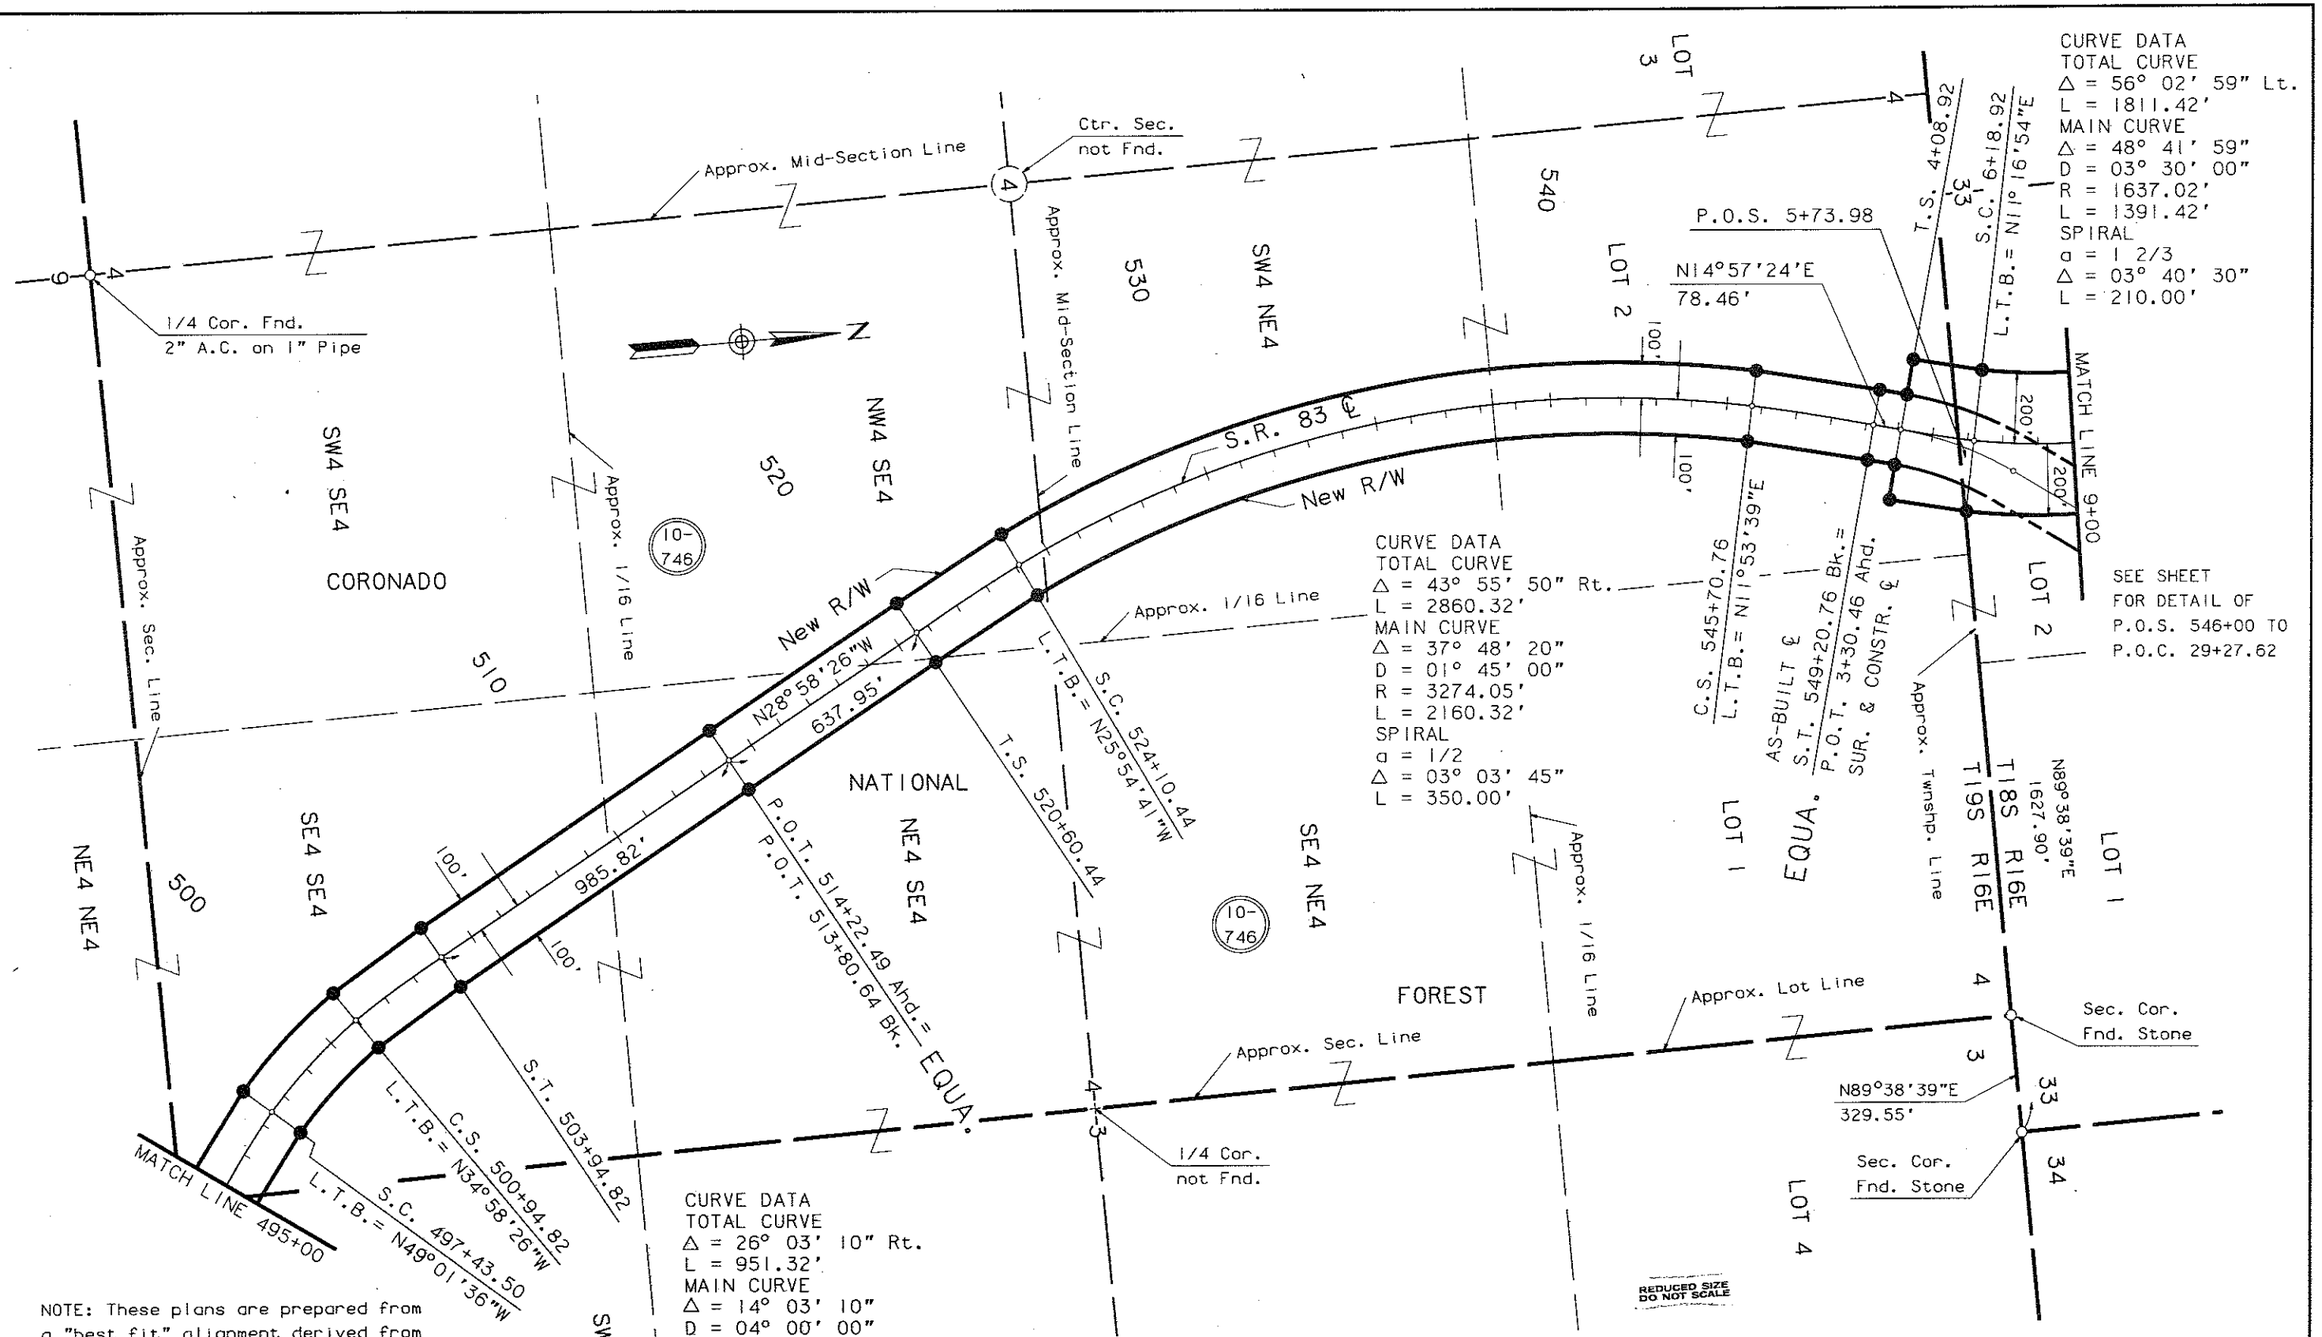

NOTE: These plans are prepared from a "best fit" alignment derived from as built plans, S-249 (4), Non F.A.S. 249 (1956) and hard copy 8709 MI-M7, and are for the express purpose of acquiring rights of way from the Coronado National Forest.

REVISIONS			
C.O. NO.	DATE	BY	DESCRIPTION
7559	10-25-87	H.E.	ADDED THIS SHEET.

DRAWING NO.	D-10-T-355
HARD COPY	8709 MI-M7
COUNTY	PIMA
DRAWN	GREINER/SEPT. '87
CHECKED	HE/OCT. '87
SCALE	1"=200'
ROUTE	S.R.83
LOCATION	CORONADO NATIONAL FOREST SECTION

ARIZONA DEPARTMENT OF TRANSPORTATION
HIGHWAYS DIVISION
RIGHT OF WAY PLANS SERVICES

HIGHWAY: PARKER CANYON LAKE-MT. VIEW
PROJECT NO. S-249-813

SHEET 6 OF 12

OF

Click here for SR 83 Index

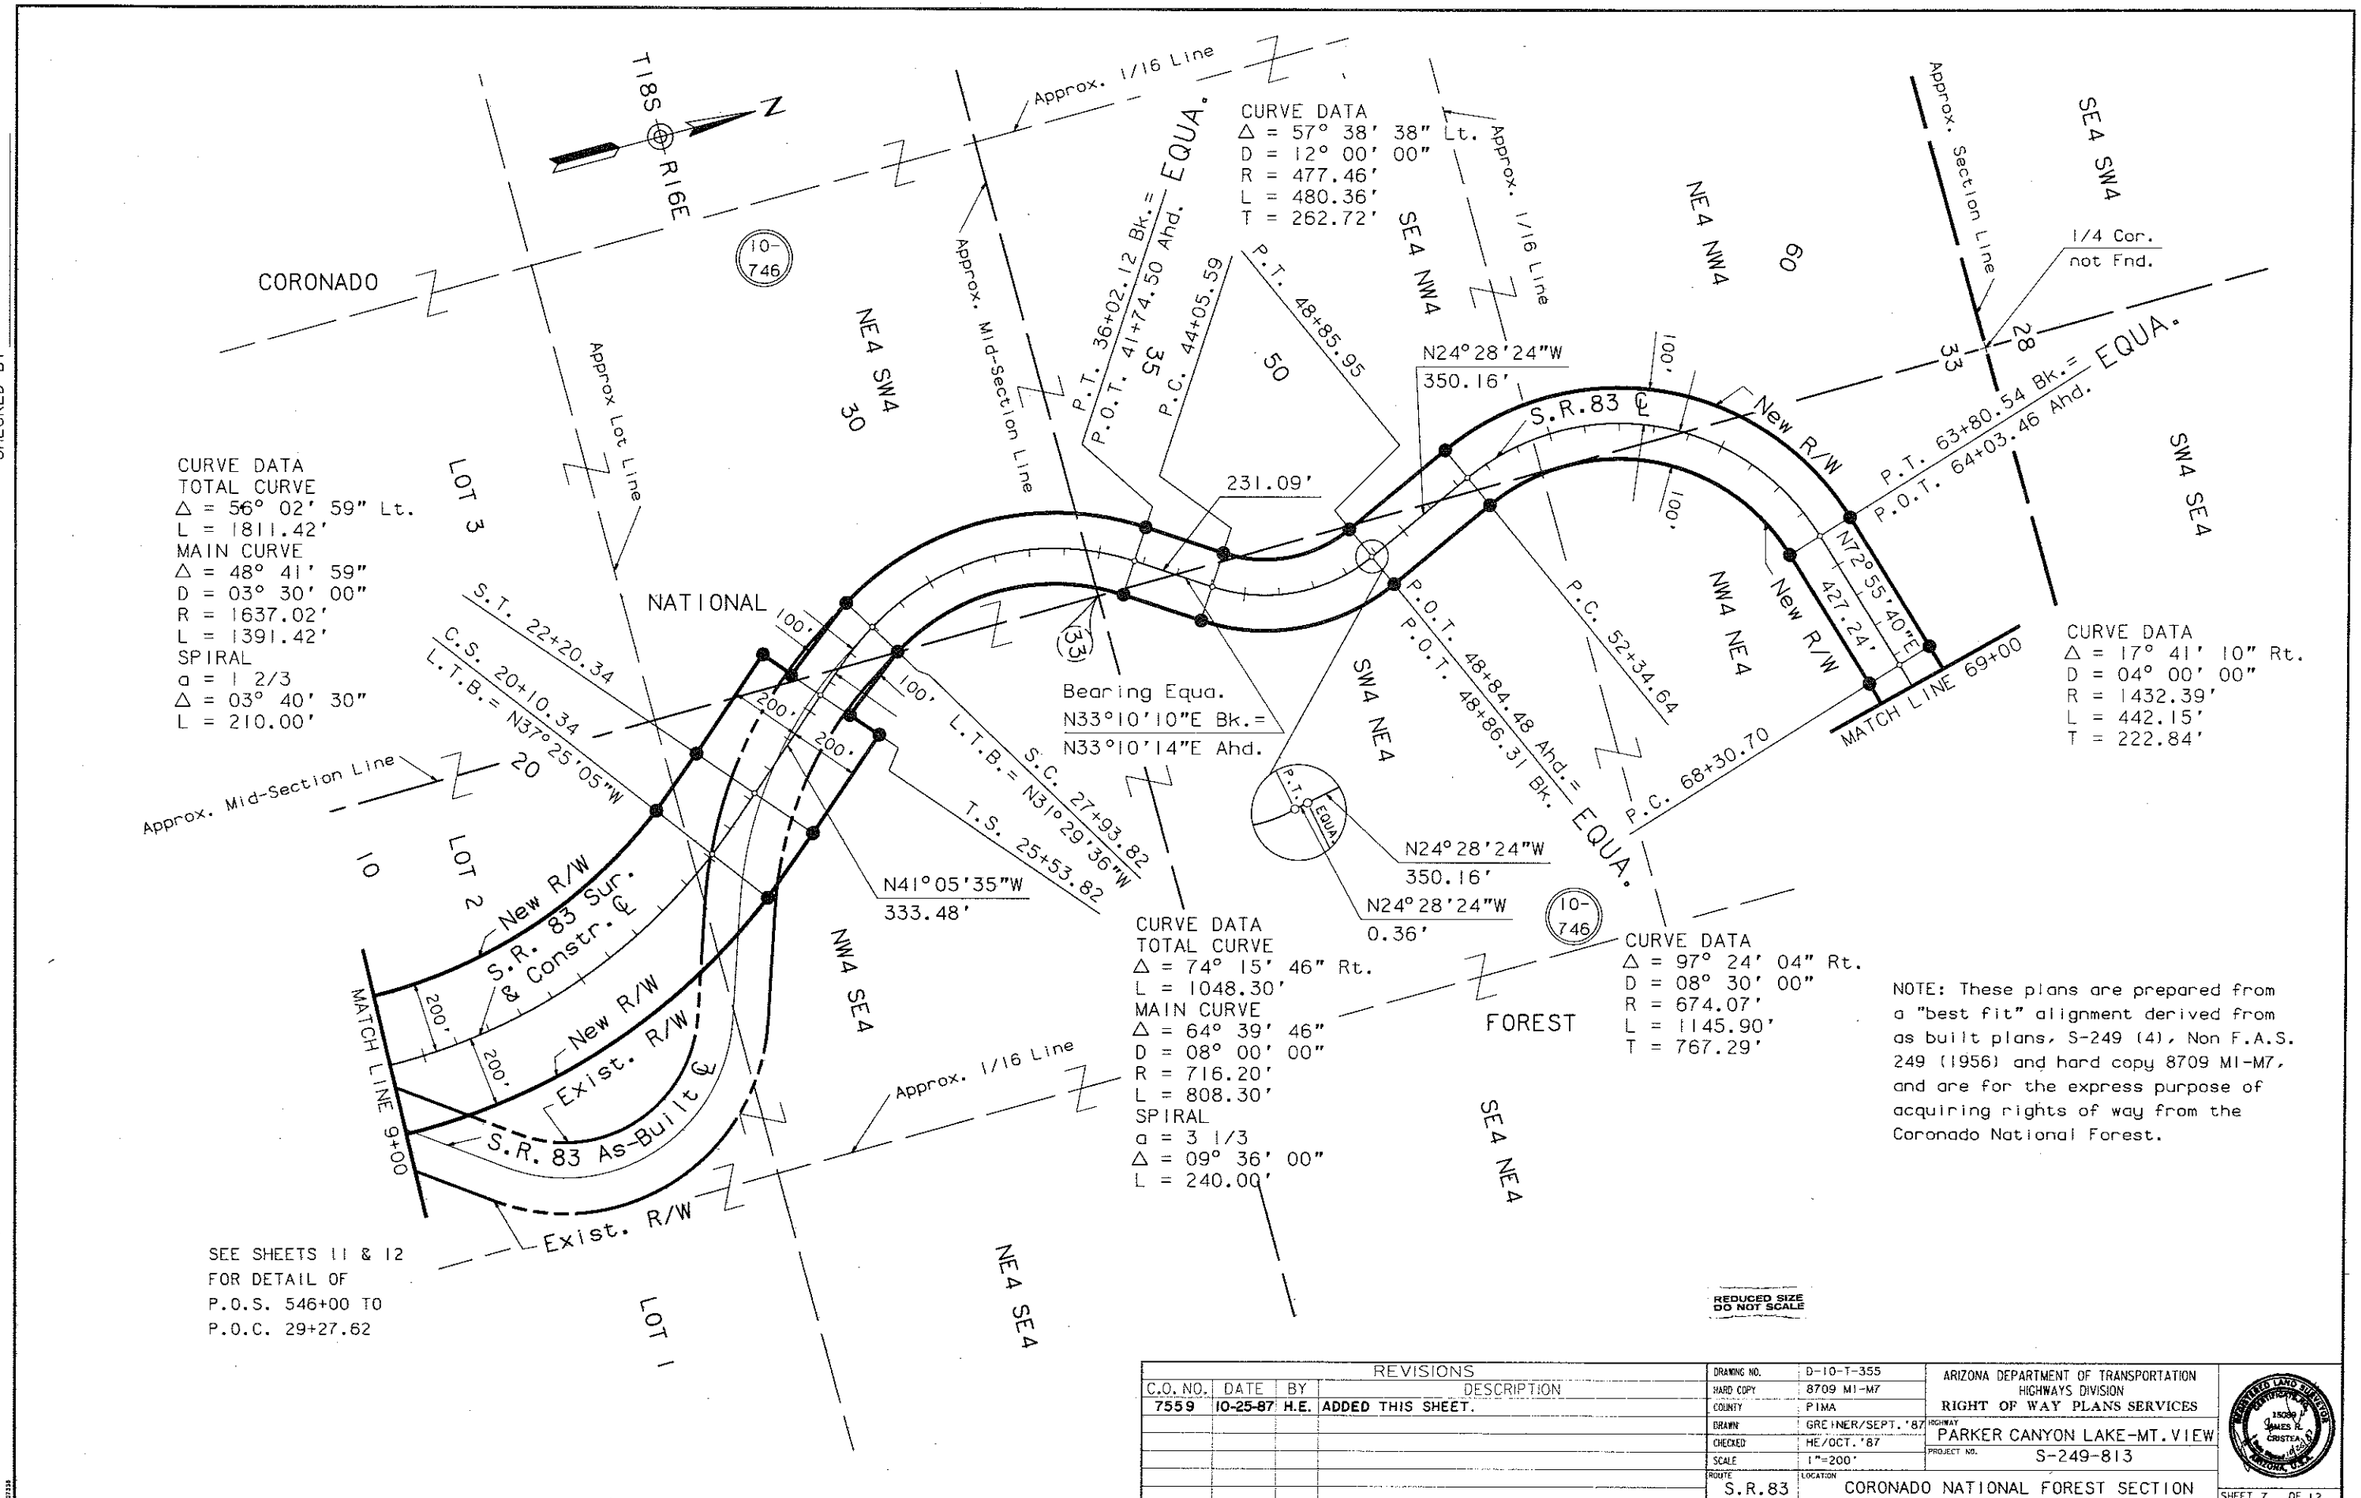

NOTE: These plans are prepared from a "best fit" alignment derived from as built plans, S-249 (4), Non F.A.S. 249 (1956) and hard copy 8709 MI-M7, and are for the express purpose of acquiring rights of way from the Coronado National Forest.

SEE SHEETS 11 & 12 FOR DETAIL OF P.O.S. 546+00 TO P.O.C. 29+27.62

REVISIONS			
C.O. NO.	DATE	BY	DESCRIPTION
7559	10-25-87	H.E.	ADDED THIS SHEET.

DRAWING NO.	D-10-T-355
HARD COPY	8709 MI-M7
COUNTY	PIMA
DRAWN	GREINER/SEPT. '87
CHECKED	HE/OCT. '87
SCALE	1"=200'
ROUTE	S.R.83

ARIZONA DEPARTMENT OF TRANSPORTATION
HIGHWAYS DIVISION
RIGHT OF WAY PLANS SERVICES

HIGHWAY: PARKER CANYON LAKE-MT. VIEW
PROJECT NO.: S-249-813
LOCATION: CORONADO NATIONAL FOREST SECTION

SHEET 7 OF 12

___ OF ___

Click here for SR 83 Index

NOTE: These plans are prepared from a "best fit" alignment derived from as built plans, S-249 (4), Non F.A.S. 249 (1956) and hard copy 8709 MI-M7, and are for the express purpose of acquiring rights of way from the Coronado National Forest.

CHECKED BY

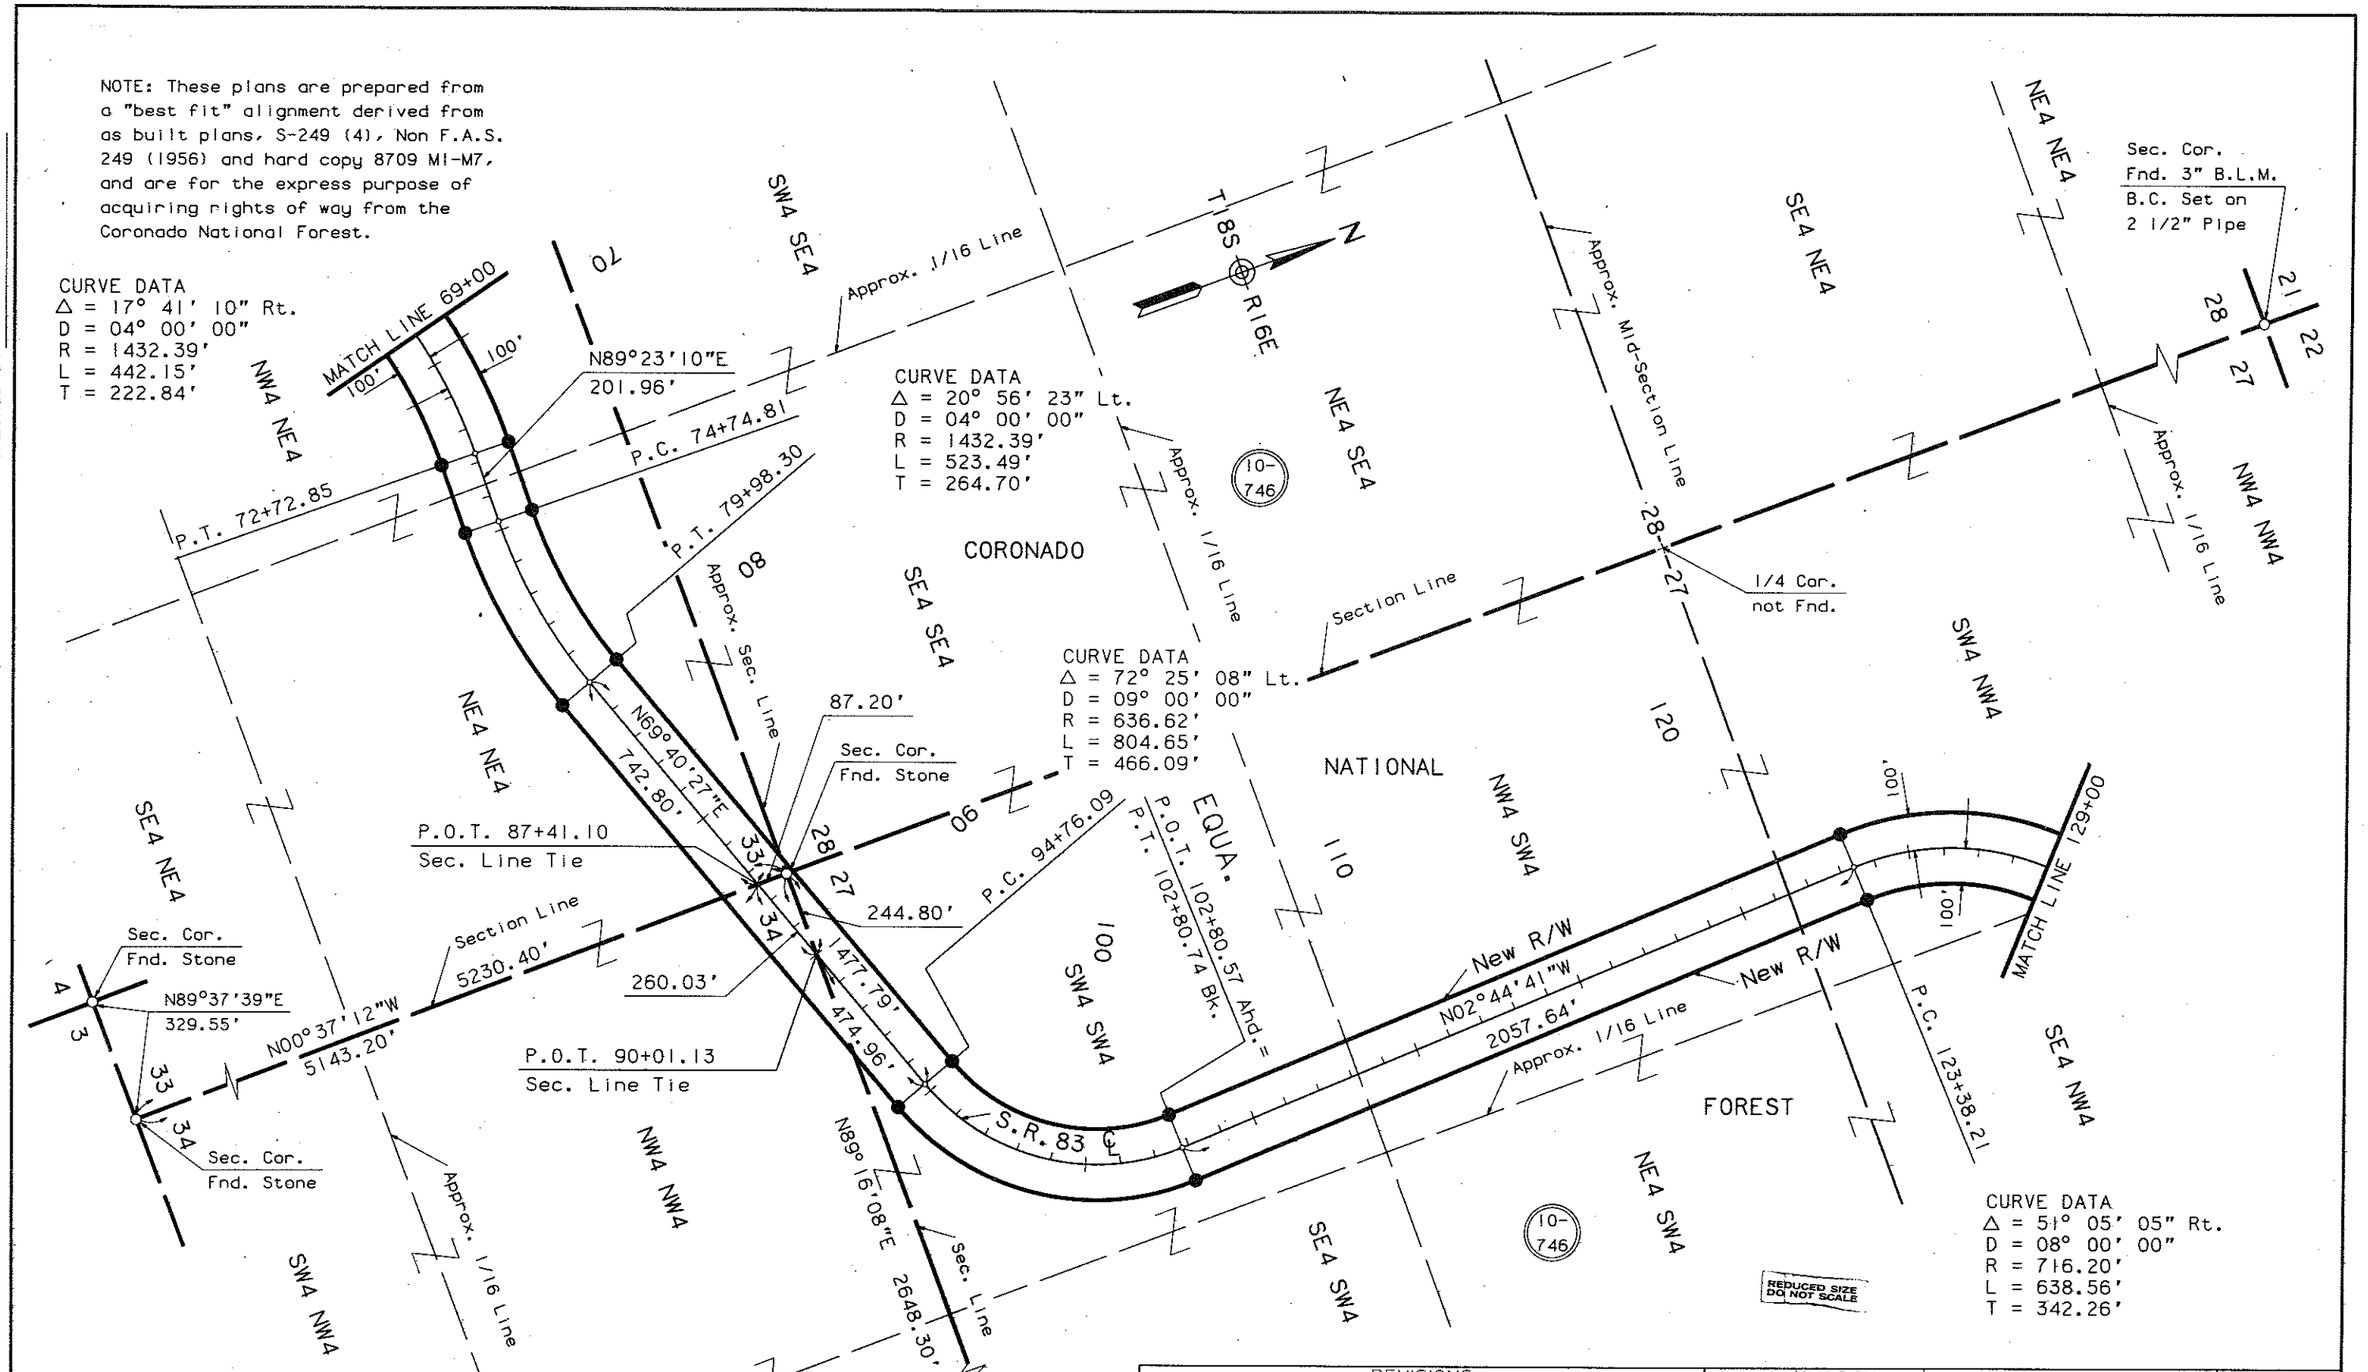

REVISIONS			
C.O. NO.	DATE	BY	DESCRIPTION
7559	10-25-87	H.E.	ADDED THIS SHEET.

DRAWING NO.	D-10-T-355
HARD COPY	8709 MI-M7
COUNTY	PIMA
DRAWN	GREINER/SEPT. '87
CHECKED	HE/OCT. '87
SCALE	1"=200'
ROUTE	S.R. 83

ARIZONA DEPARTMENT OF TRANSPORTATION
HIGHWAYS DIVISION
RIGHT OF WAY PLANS SERVICES

HIGHWAY: PARKER CANYON LAKE-MT. VIEW
PROJECT NO. S-249-813
LOCATION: CORONADO NATIONAL FOREST SECTION

SHEET 8 OF 12

OF

Click here for SR 83 Index

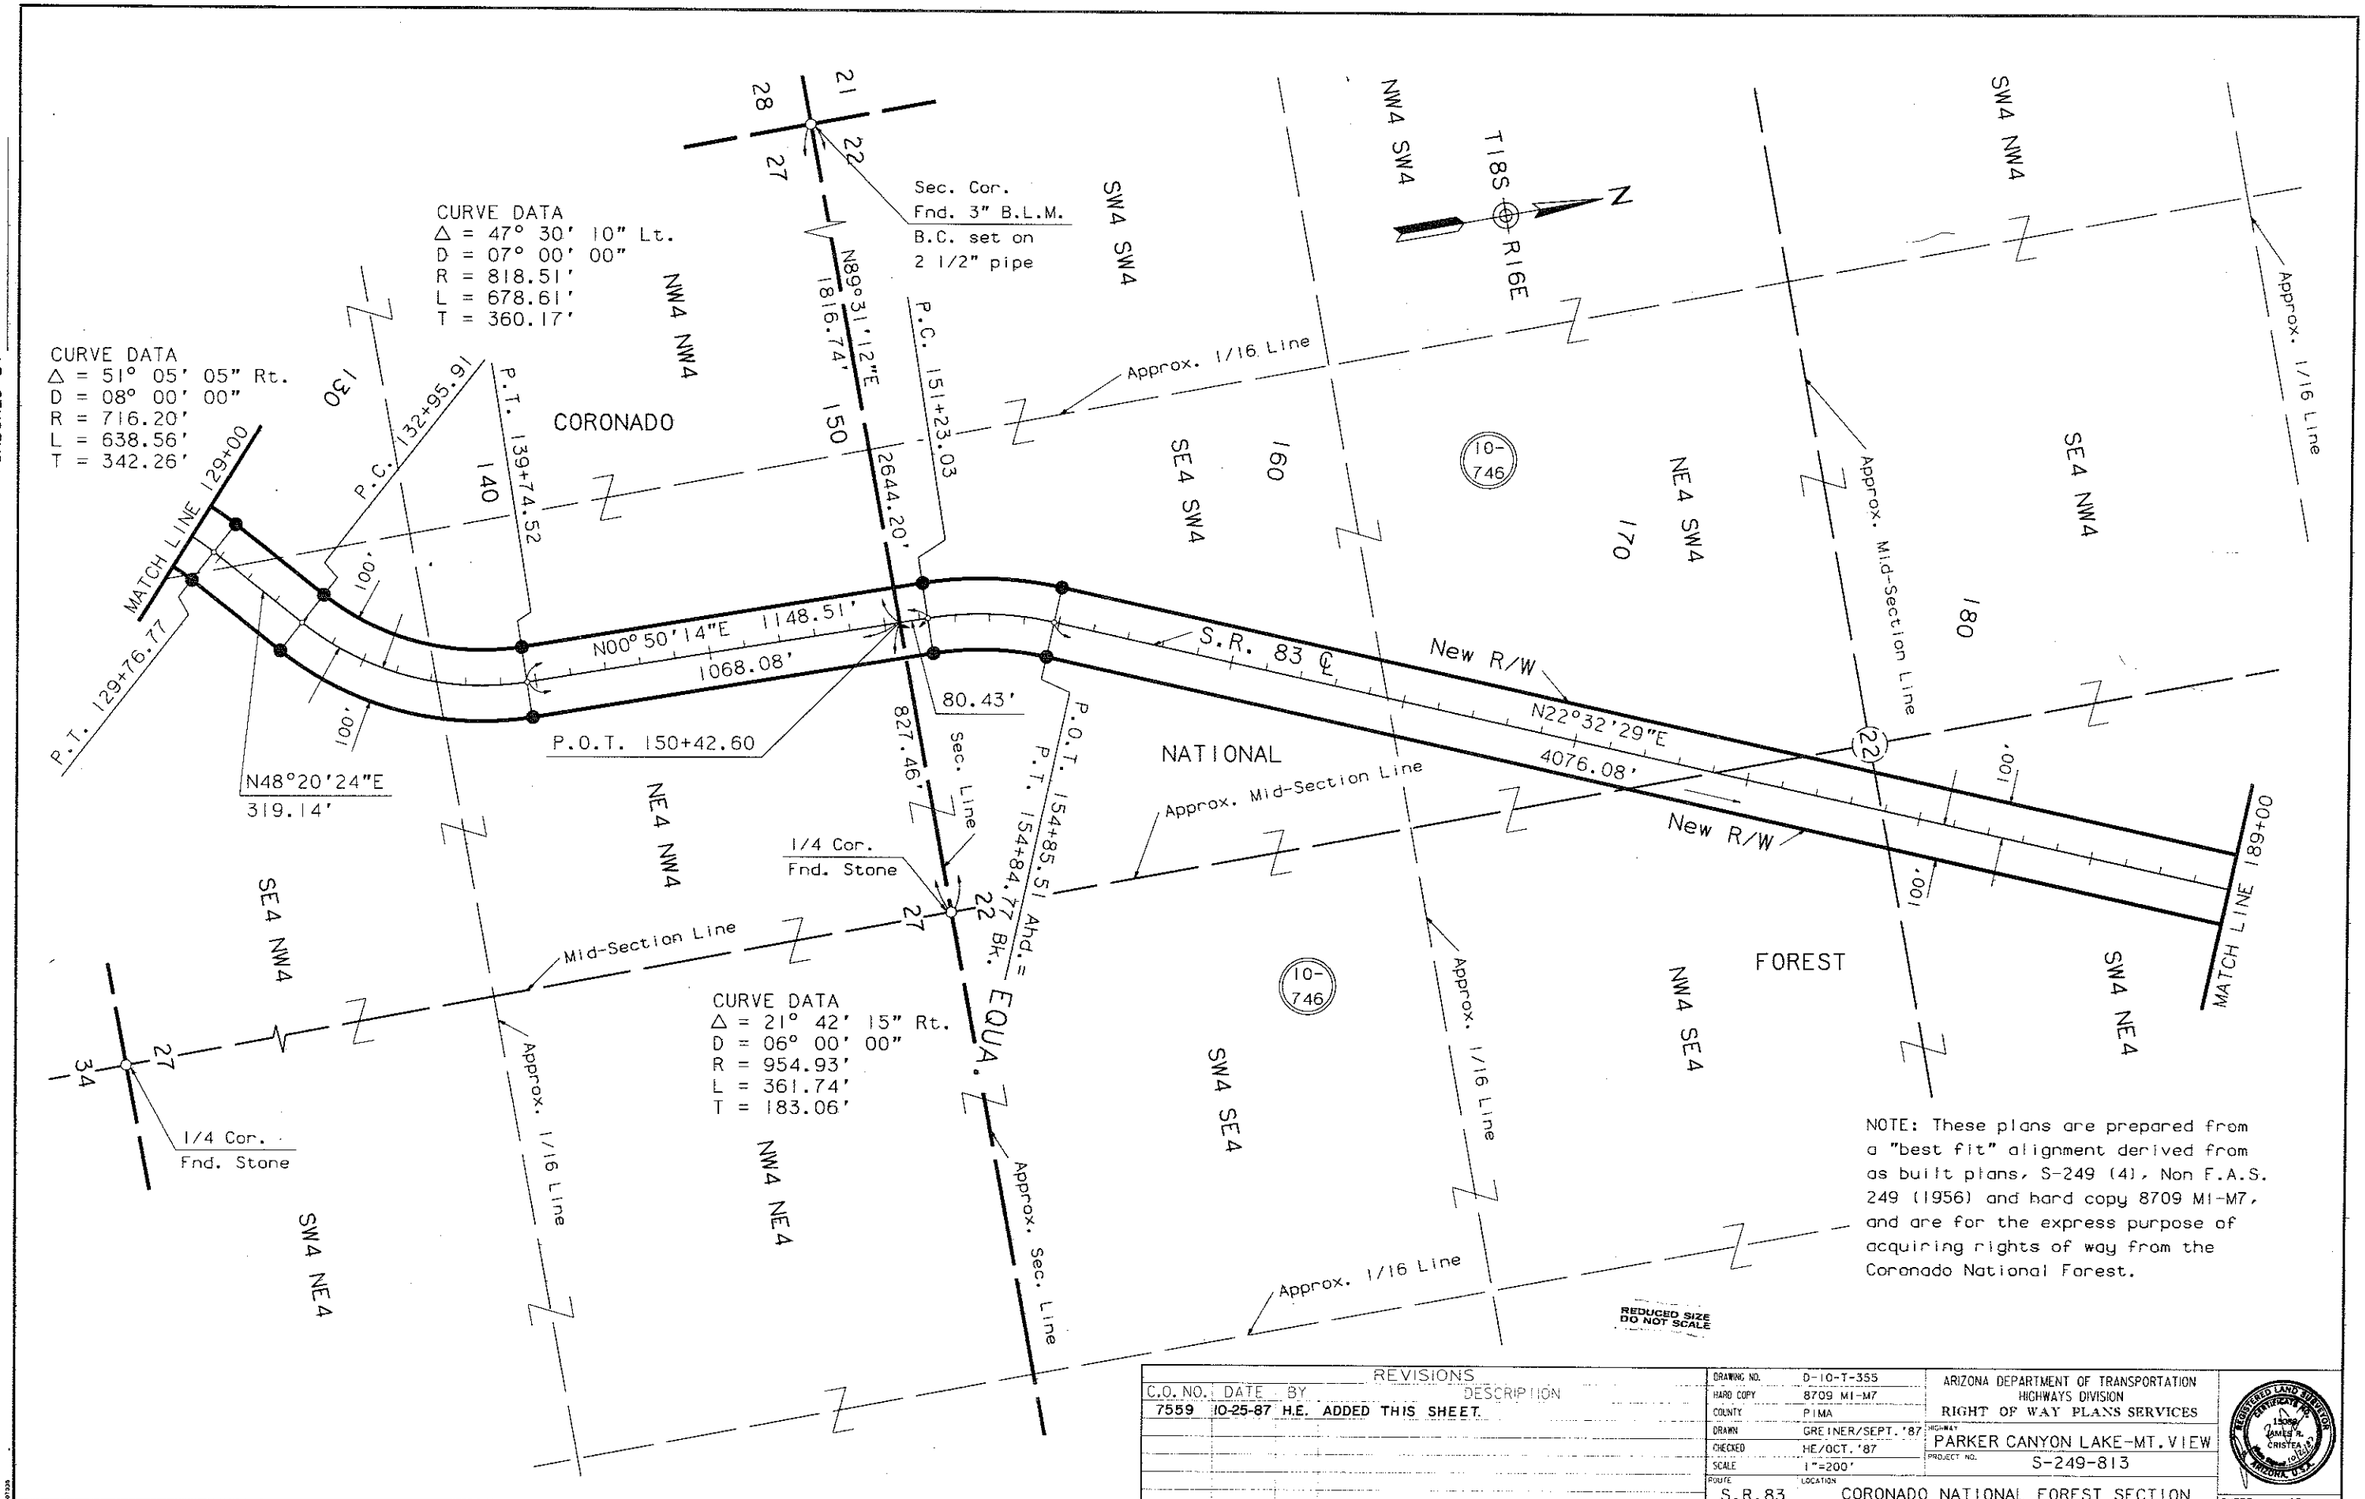

NOTE: These plans are prepared from a "best fit" alignment derived from as built plans, S-249 (4), Non F.A.S. 249 (1956) and hard copy 8709 M1-M7, and are for the express purpose of acquiring rights of way from the Coronado National Forest.

REVISIONS			
C.O. NO.	DATE	BY	DESCRIPTION
7559	10-25-87	H.E.	ADDED THIS SHEET.

DRAWING NO.	D-10-T-355
HARD COPY	8709 M1-M7
COUNTY	PIMA
DRAWN	GREINER/SEPT. '87
CHECKED	HE/OCT. '87
SCALE	1"=200'
ROUTE	S.R.83
LOCATION	CORONADO NATIONAL FOREST SECTION

ARIZONA DEPARTMENT OF TRANSPORTATION
HIGHWAYS DIVISION
RIGHT OF WAY PLANS SERVICES

HIGHWAY: PARKER CANYON LAKE-MT. VIEW
PROJECT NO. S-249-813

SHEET 9 OF 12

___ OF ___

Click here for SR 83 Index

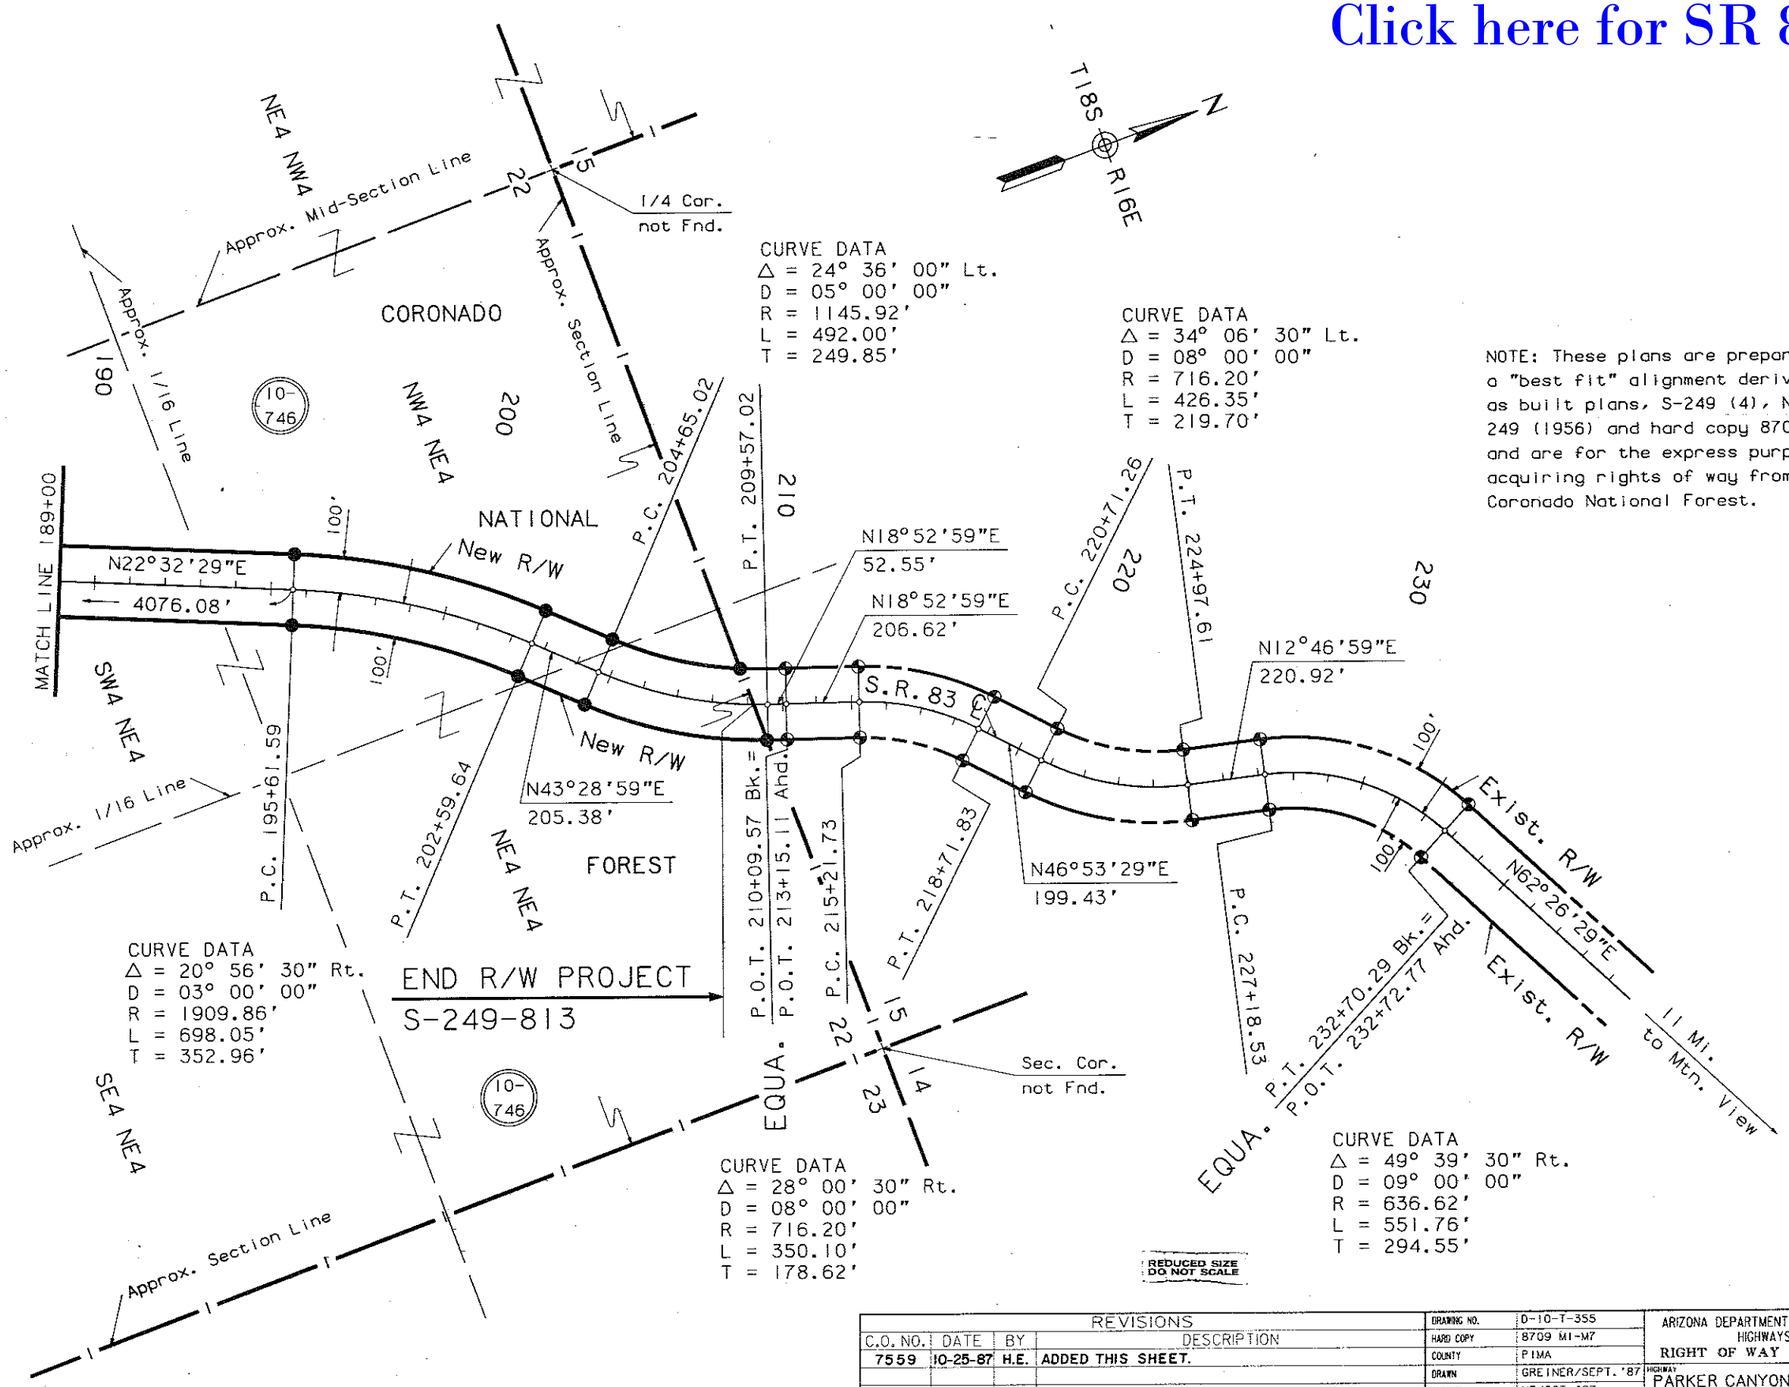

NOTE: These plans are prepared from a "best fit" alignment derived from as built plans, S-249 (4), Non F.A.S. 249 (1956) and hard copy 8709 MI-M7, and are for the express purpose of acquiring rights of way from the Coronado National Forest.

CHECKED BY

REVISIONS			
C.O. NO.	DATE	BY	DESCRIPTION
7559	10-25-87	H.E.	ADDED THIS SHEET.

DRAWING NO.	D-10-T-355
HARD COPY	8709 MI-M7
COUNTY	PIMA
DRAWN	GREINER/SEPT. '87
CHECKED	HE/OCT. '87
SCALE	1"=200'
ROUTE	S.R.83

ARIZONA DEPARTMENT OF TRANSPORTATION
HIGHWAYS DIVISION
RIGHT OF WAY PLANS SERVICES

HIGHWAY: PARKER CANYON LAKE-MT. VIEW
PROJECT NO. S-249-813
LOCATION: CORONADO NATIONAL FOREST SECTION

SHEET 10 OF 12

OF

Click here for SR 83 Index

NOTE: Existing R/W acquired under project NON. F.A.S. 249(1956)

OWNERSHIP RECORD										ACQUISITION RECORD				
PARCEL NUMBER	OWNER	DESCRIPTION	TOTAL AREA	AREA REQUIRED: GROSS INCLUDING EXISTING R/W	AREA REQUIRED: NET EXCLUDING EXISTING R/W	EASEMENT AREA	REMAINDER: LEFT	REMAINDER: RIGHT	SHEET NUMBER	BOARD APPROVAL	TYPE & DATE OF INSTRUMENT	RECORDED: DATE	RECORDED: BOOK	RECORDED: PAGE
10-746	U.S.A. (Coronado National Forest)	Pt. of Sec. 33, T.18 S., R. 16 E.			~~9.19 Ac.~~ 13.09 Ac.	~~6.48 Ac.~~ T.C.E. 36.74 Ac.			1 & 2					
		Pt. of Sec. 4, T.19 S., R. 16 E.			~~0.02 Ac.~~ 0.72 Ac.	~~1.45 Ac.~~ T.C.E. 1.11 Ac.			1 & 2					
M - 1	Dennis Lauderbach et al	Pt. of Unpatented Mining Claims Wasp 306, 308, 310, 401, 403, 405, 407 & Max 59 Located in Sec. 33, T. 18 S., R. 16 E. & Sec. 4, T. 19 S., R. 16 E.			~~9.21 Ac.~~ 13.81 Ac.				1 & 2					

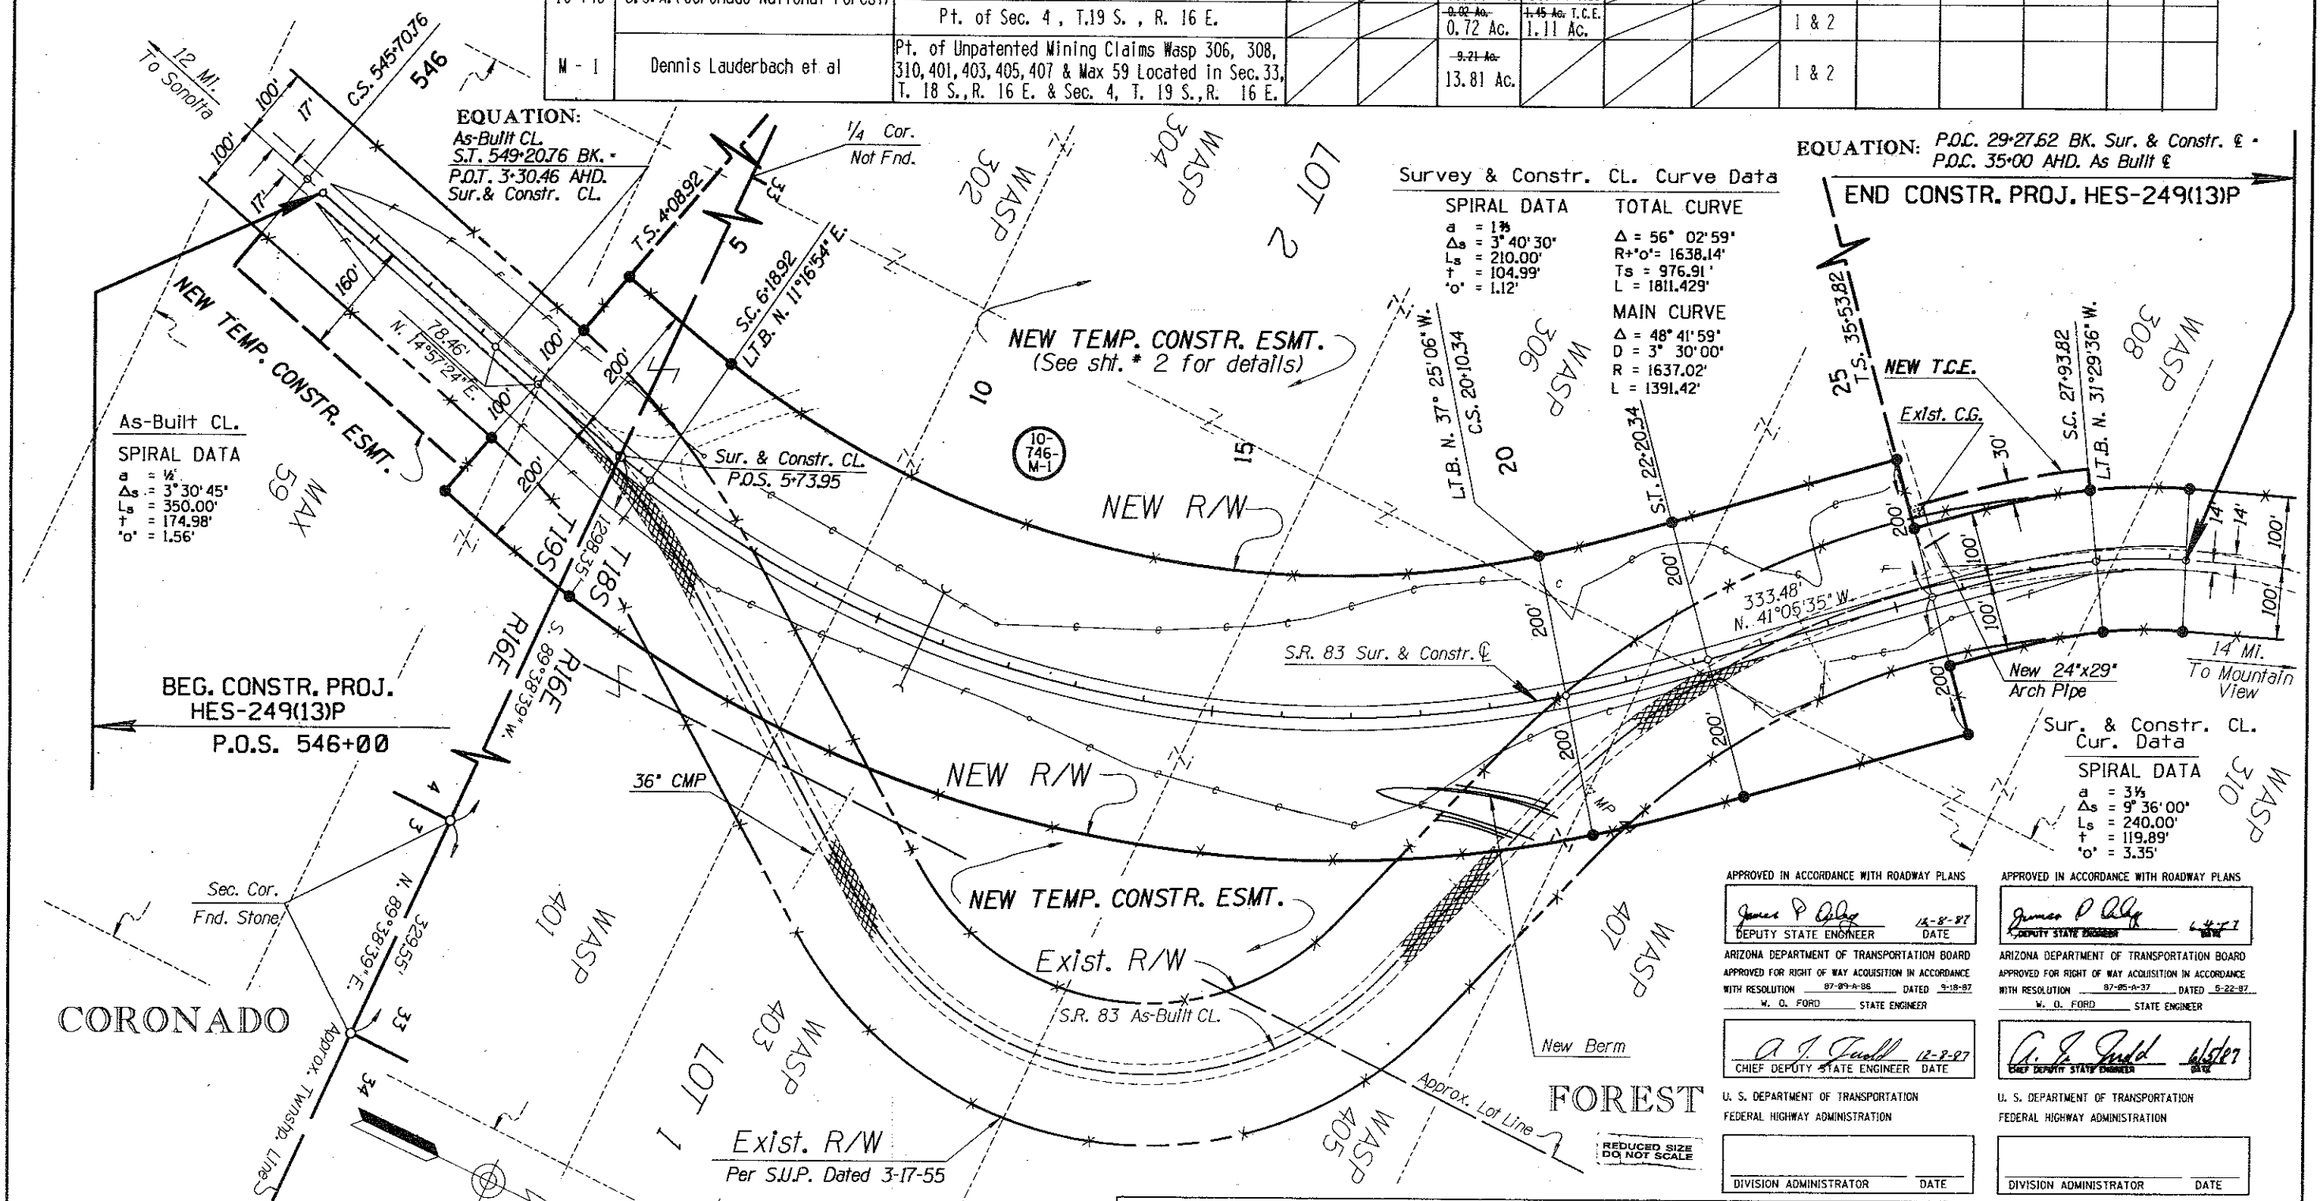

APPROVED IN ACCORDANCE WITH ROADWAY PLANS
DEPUTY STATE ENGINEER 12-8-87 DATE
ARIZONA DEPARTMENT OF TRANSPORTATION BOARD
APPROVED FOR RIGHT OF WAY ACQUISITION IN ACCORDANCE WITH RESOLUTION 87-89-A-86 DATED 9-18-87
W. O. FORD STATE ENGINEER
CHIEF DEPUTY STATE ENGINEER 12-8-87 DATE
U. S. DEPARTMENT OF TRANSPORTATION
FEDERAL HIGHWAY ADMINISTRATION
DIVISION ADMINISTRATOR DATE

APPROVED IN ACCORDANCE WITH ROADWAY PLANS
ARIZONA DEPARTMENT OF TRANSPORTATION BOARD
APPROVED FOR RIGHT OF WAY ACQUISITION IN ACCORDANCE WITH RESOLUTION 87-85-A-37 DATED 5-22-87
W. O. FORD STATE ENGINEER
CHIEF DEPUTY STATE ENGINEER 12/5/87 DATE
U. S. DEPARTMENT OF TRANSPORTATION
FEDERAL HIGHWAY ADMINISTRATION
DIVISION ADMINISTRATOR DATE

PUBLIC HEARING REQUIREMENTS CERTIFIED N/R
ENVIRONMENTAL CLEARANCE 7-22-87

REVISIONS			
C.O. NO.	DATE	BY	DESCRIPTION
7528	6-19-87	H.E.	ADD TCE'S RT. 543 ± & 25+50 ±
7573	8-18-87	"	REV'D TCE LT. 5+00 TO 25+53.82, CHANGED R/W TO
"	"	"	200', REV'D SHT. No. & ADDED NEW T.C.E. 26+50 LT.
7602	10-21-87	"	ADDED CONSTR. FEATURES ; REV. SEC. TIE AS PER
"	"	"	8709 M3 & M4
7559	10-25-87	"	REVISED SHEET No.

DRAWING NO.	D -10 -T - 355
HARD COPY	8723 T1, 8709 M3 ,M4
COUNTY	PIMA
DRAWN & DATE	H. EGHBALI \4-30-87
CHECKED	M. BRUDER
SCALE	1" = 100'
ROUTE	S.R. 83
LOCATION	CORONADO NATIONAL FOREST SECTION

ARIZONA DEPARTMENT OF TRANSPORTATION
HIGHWAYS DIVISION
RIGHT OF WAY PLANS SERVICES
HIGHWAY: PARKER CANYON LAKE-MT. VIEW
PROJECT NO. S-249-813

SHEET 11 OF 12

ZF1=45.3MNTYW.DGN1
25-NOV-1987 16:05
VIEW NAME:

___ OF ___

Click here for SR 83 Index

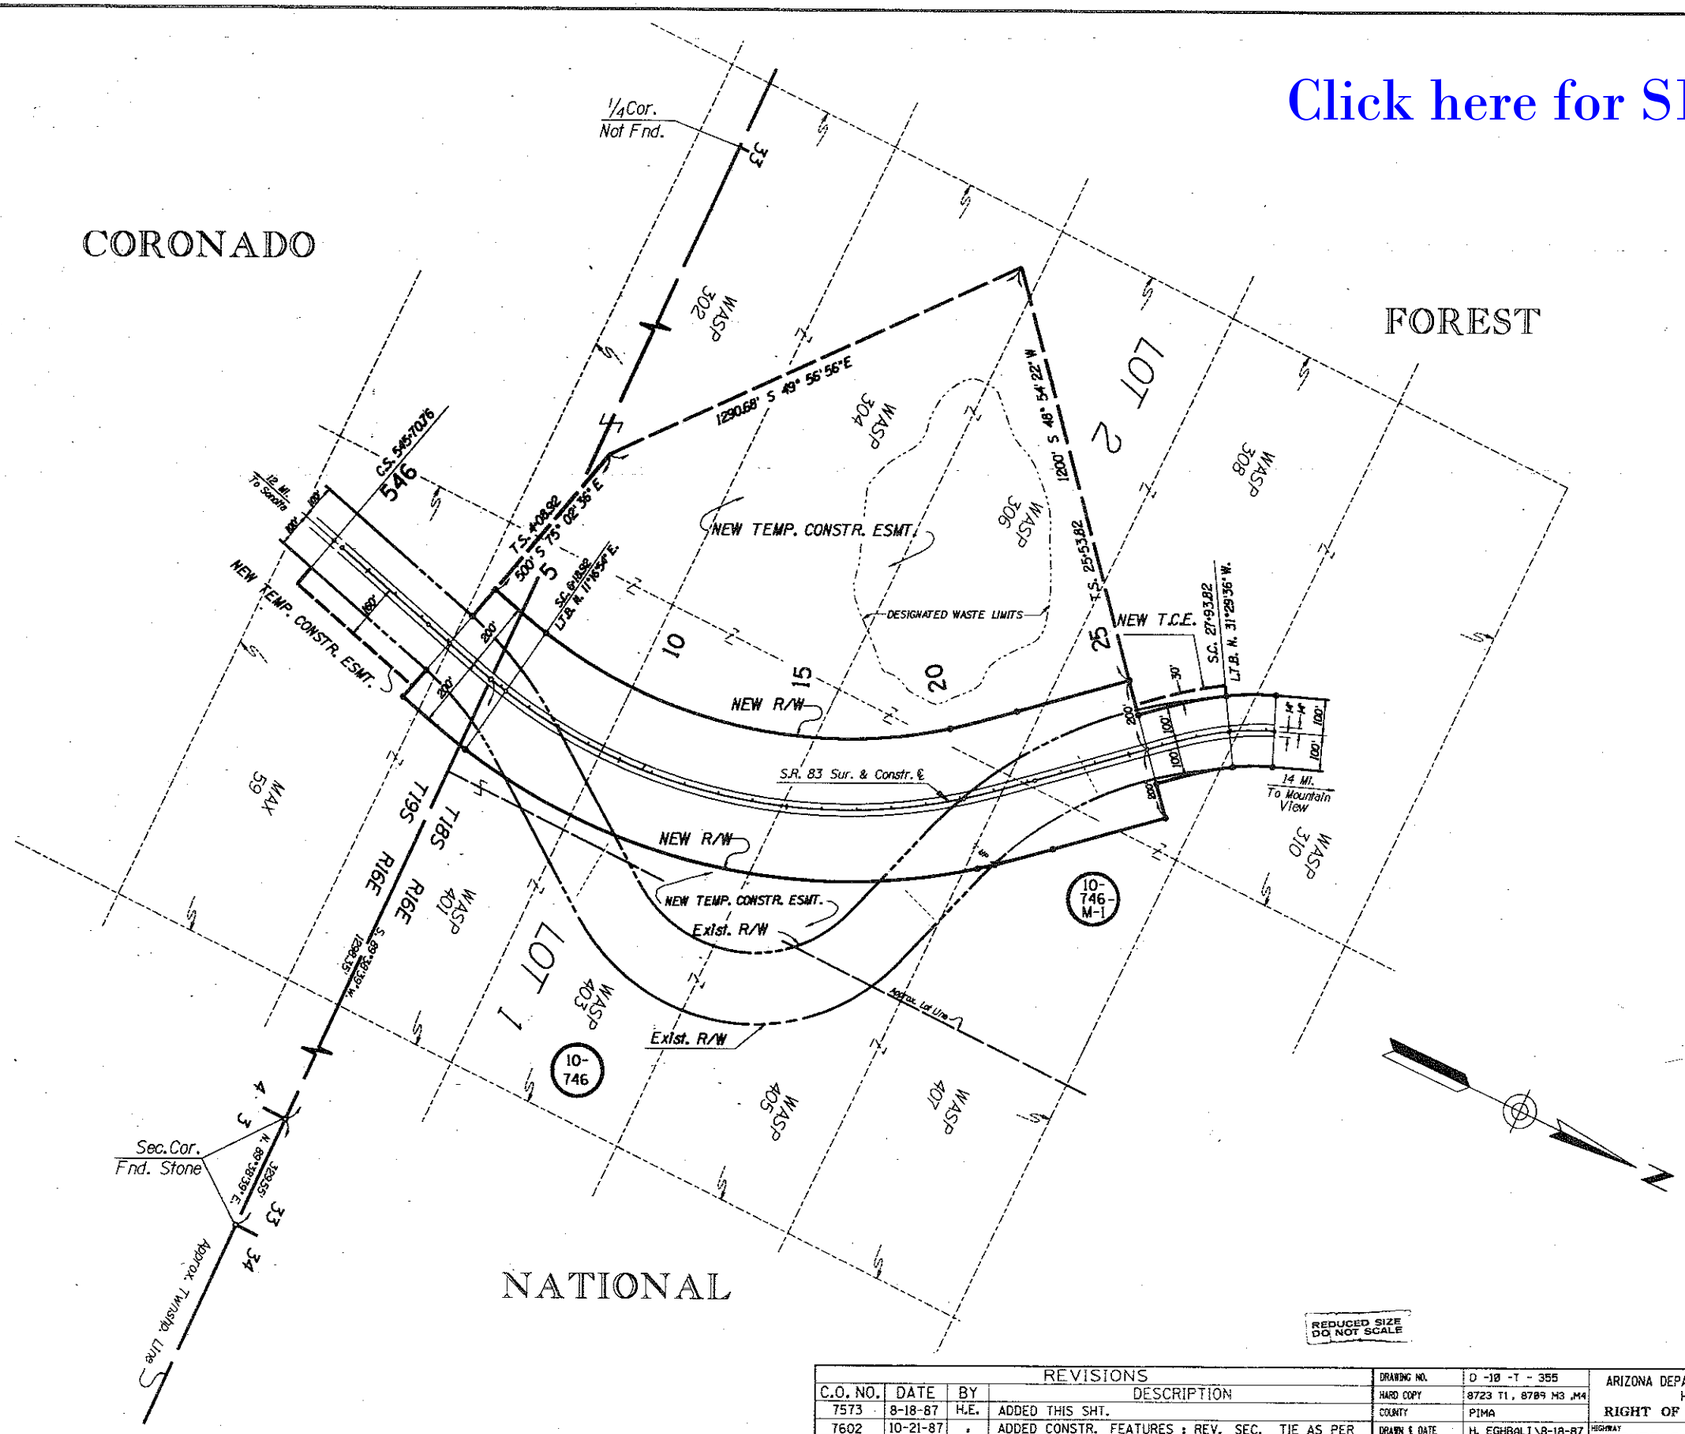

REVISIONS			
C.O. NO.	DATE	BY	DESCRIPTION
7573	8-18-87	H.E.	ADDED THIS SHT.
7602	10-21-87	"	ADDED CONSTR. FEATURES ; REV. SEC. TIE AS PER
"	"	"	8709 M3 & M4 .
7559	10-25-87	"	REVISED SHEET No.

DRAWING NO.	D -10 -T - 355
HARD COPY	8723 T1, 8709 M3, M4
COUNTY	PIMA
DRAWN & DATE	H. EGHBALI \8-18-87
CHECKED	M. BRUDER
SCALE	1" = 200'
ROUTE	S.R. 83
LOCATION	CORONADO NATIONAL FOREST SECTION

ARIZONA DEPARTMENT OF TRANSPORTATION
HIGHWAYS DIVISION
RIGHT OF WAY PLANS SERVICES

HIGHWAY: PARKER CANYON LAKE-MT. VIEW

PROJECT NO. S-249-813

SHEET 12 OF 12

ZFI:\45,3\MNTVW.DGN1 VIEW NAME:
25-NOV-1987 16:09

OF