MESA - PAYSON HIGHWAY
SYCAMORE CREEK
MARICOPA COUNTY

OWNERSHIP RECORD

PARCEL NUMBER	OWNER	DESCRIPTION	TOTAL AREA	AREA REQUIRED: GROSS INCLUDING EXISTING R/W	AREA REQUIRED: NET EXCLUDING EXISTING R/W	EASEMENT AREA	REMAINDER: LEFT	REMAINDER: RIGHT
7-2790	Transamerica Title Ins. Co., Trustee; Trust No. 9351	Pt. of H.E.S. 445, T. 5 N. R. 8 E.	120.80Ac.	8.30 Ac.		* ~~5.28 Ac.~~ D.E. 4.80Ac.	~~50.10 Ac.~~ 49.40 Ac.	~~57.12 Ac.~~ 58.30Ac.

NOTE: Parcel 7-2790 Board Approval 10-10-79. D.E. Dated 4-12-79, Recorded 10-25-79, Dkt. # 13985, Pg. 335-336

REVISIONS			
C.O. No.	DATE	BY	DESCRIPTION
5272	12-8-78	D.J.H.	Chged per constr. plans Drn. Esmt. Rt. & Dyke; added Drn.
"	"	"	Esmt. Lt.; Completed C & S. Review.
5310	2-8-79	K.G.	Added FHWA Limits & note rt. of bridge
5395	6-18-79	R.L.R.	Added Info. For 3/4" water line callout.
"	"	"	Chgd. Lec. Haul Rd. & Brng. Twnsp. Line C&S
5466	9-28-79	R.L.R.	Added Bank Prot. (60') Rt. 2193+80± Brid
5980	3-22-82	PJM	Finalized

PROJECT NO.	ER-900(5)
DRAWING NO.	D-7-T-760
SHEET NO.	1 of 1
DRAWN BY	D. J. Holmes
DATE COMP.	10-23-78
SCALE	1" = 100'

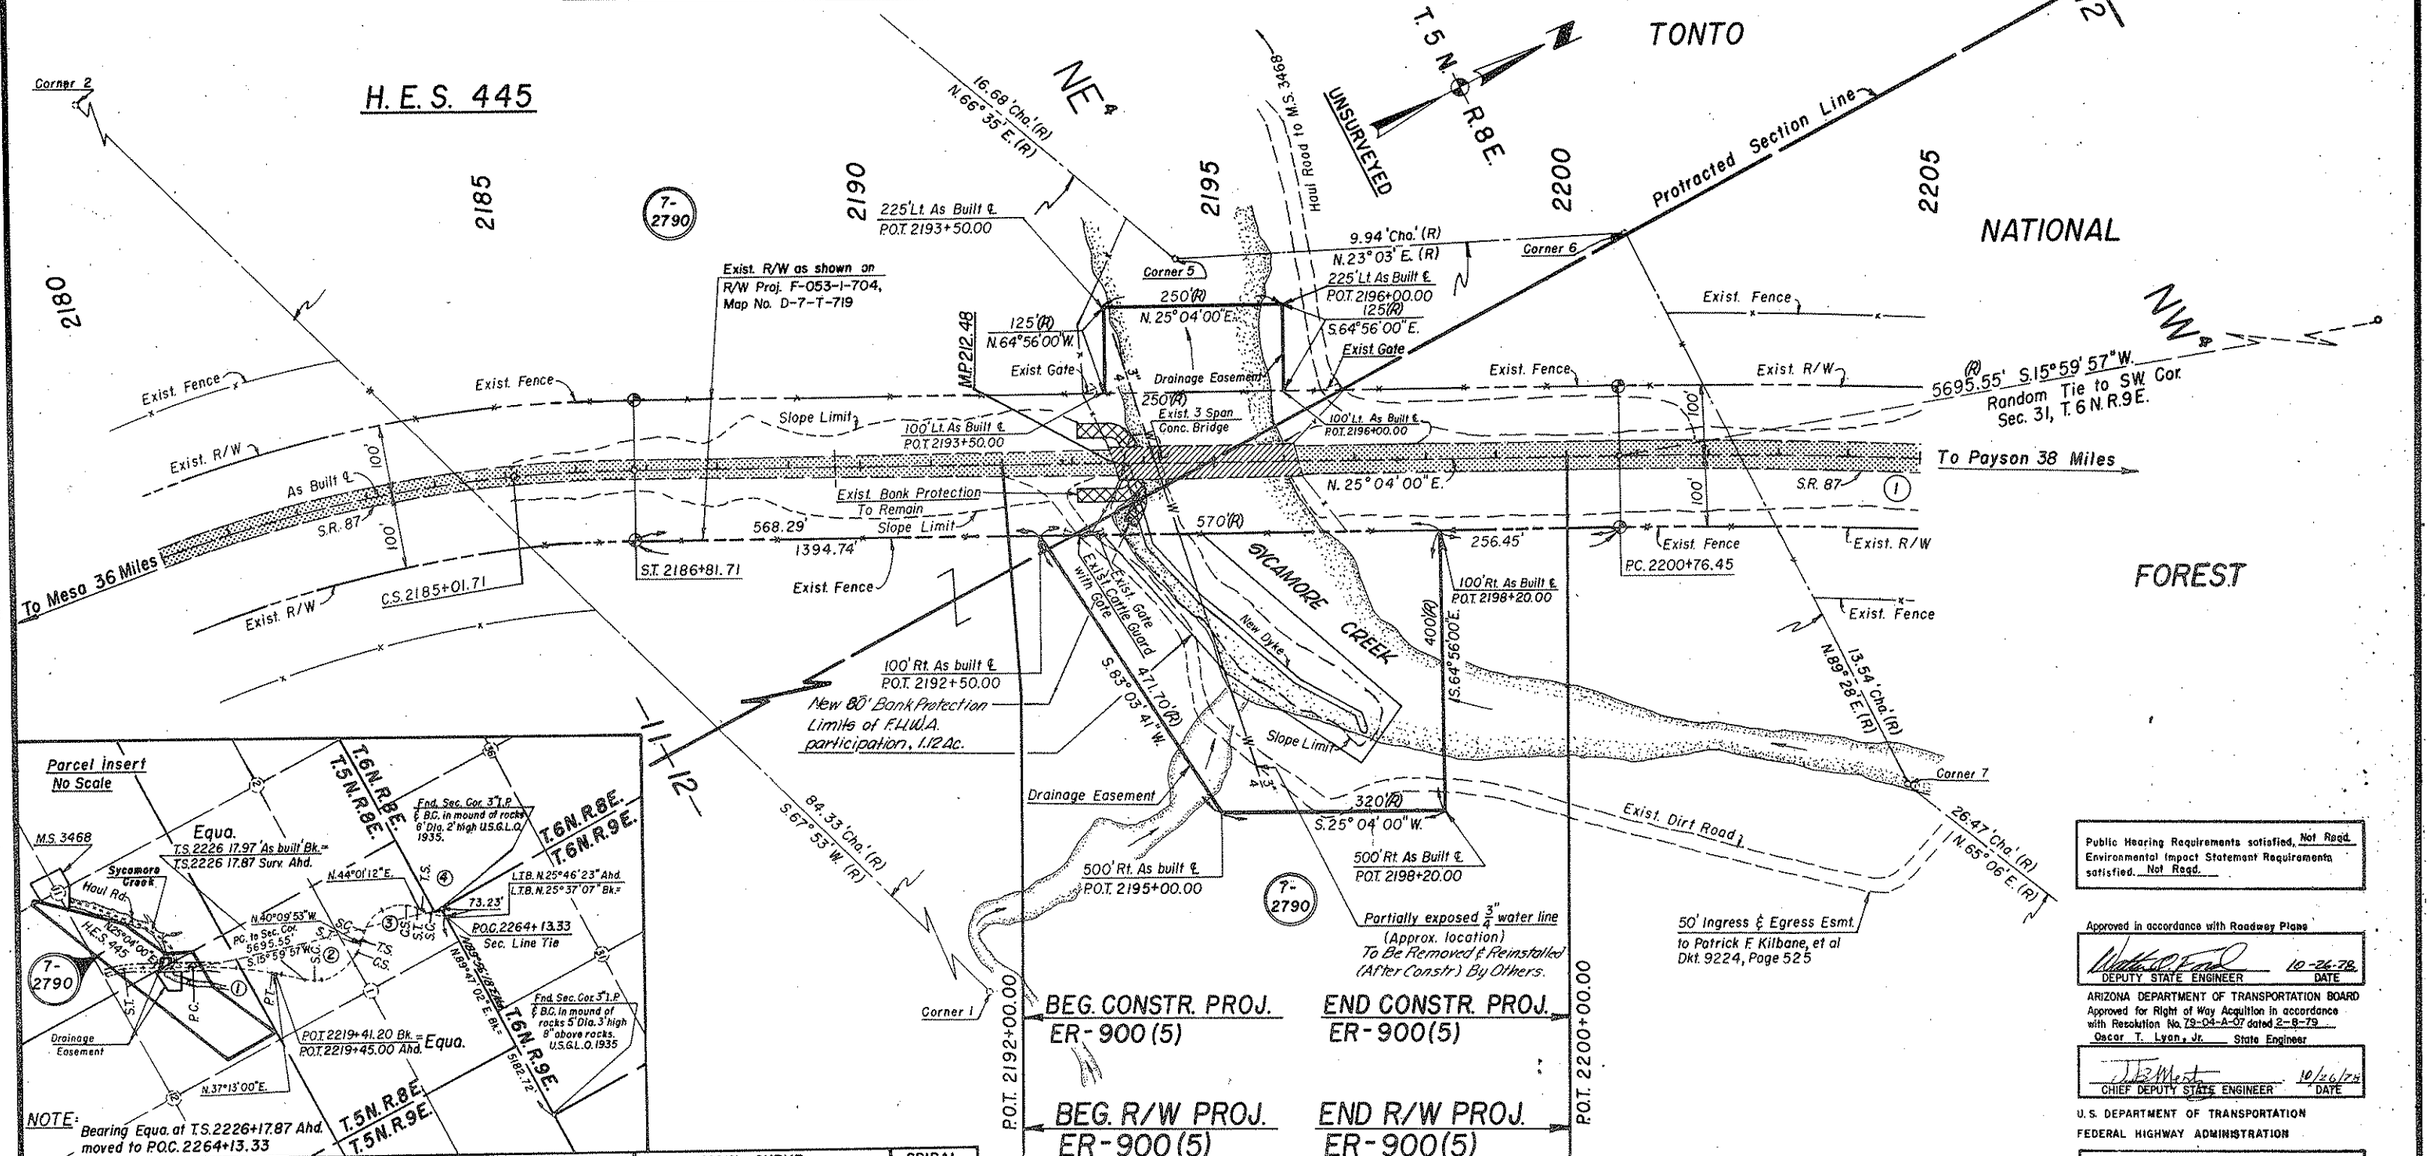

CURVE No.	P.C. or T.S.	S.C.	C.S.	P.T. or S.T.	TOTAL CURVE: I	TOTAL CURVE: R+o'	TOTAL CURVE: T_s	TOTAL CURVE: L	MAIN CURVE: Δ	MAIN CURVE: D	MAIN CURVE: R	MAIN CURVE: L	SPIRAL: a	SPIRAL: L_s
①	2200+76.45	—	—	2218+98.95	—	—	—	—	12°09'00" Rt.	0°40'00"	8594.37'	1822.50'	—	—
②	2226+17.87	2228+37.87	2240+24.80	2242+44.80	77°22'53" Lt.	1043.68'	945.82'	1626.93'	65°16'53" Lt.	5°30'00"	1041.73'	1186.93'	2½	220.0'
③	2242+94.06	2245+34.06	2256+97.14	2259+37.14	84°11'05" Rt.	957.44'	984.82'	1643.08'	69°47'05" Rt.	6°00'00"	954.93	1163.08	2½	240.0'
④	2259+86.64	2262+26.64	2268+58.59	2270+58.59	51°07'02" Lt.	957.44'	577.82'	1071.95'	37°55'02" Lt.	6°00'00"	954.93'	637.95'	2½	240.0'

Public Hearing Requirements satisfied, Not Reqd.
Environmental Impact Statement Requirements satisfied. Not Reqd.

Approved in accordance with Roadway Plans
DEPUTY STATE ENGINEER — DATE 10-26-78

ARIZONA DEPARTMENT OF TRANSPORTATION BOARD
Approved for Right of Way Acquition in accordance with Resolution No. 79-04-A-07 dated 2-8-79
Oscar T. Lyon, Jr. State Engineer
CHIEF DEPUTY STATE ENGINEER — DATE 10/26/78

U.S. DEPARTMENT OF TRANSPORTATION
FEDERAL HIGHWAY ADMINISTRATION
DIVISION ENGINEER — DATE

REDUCED SIZE DO NOT SCALE

HARD COPY 'As Built' ER FO-053-1-(12). CHECKED BY. Gary Hoppe

BRUNING 44-512

Click here for SR 87 Index