DOUGLAS – SAFFORD HWY.
SAFFORD STREETS
GRAHAM COUNTY

Click here for US 191 Index

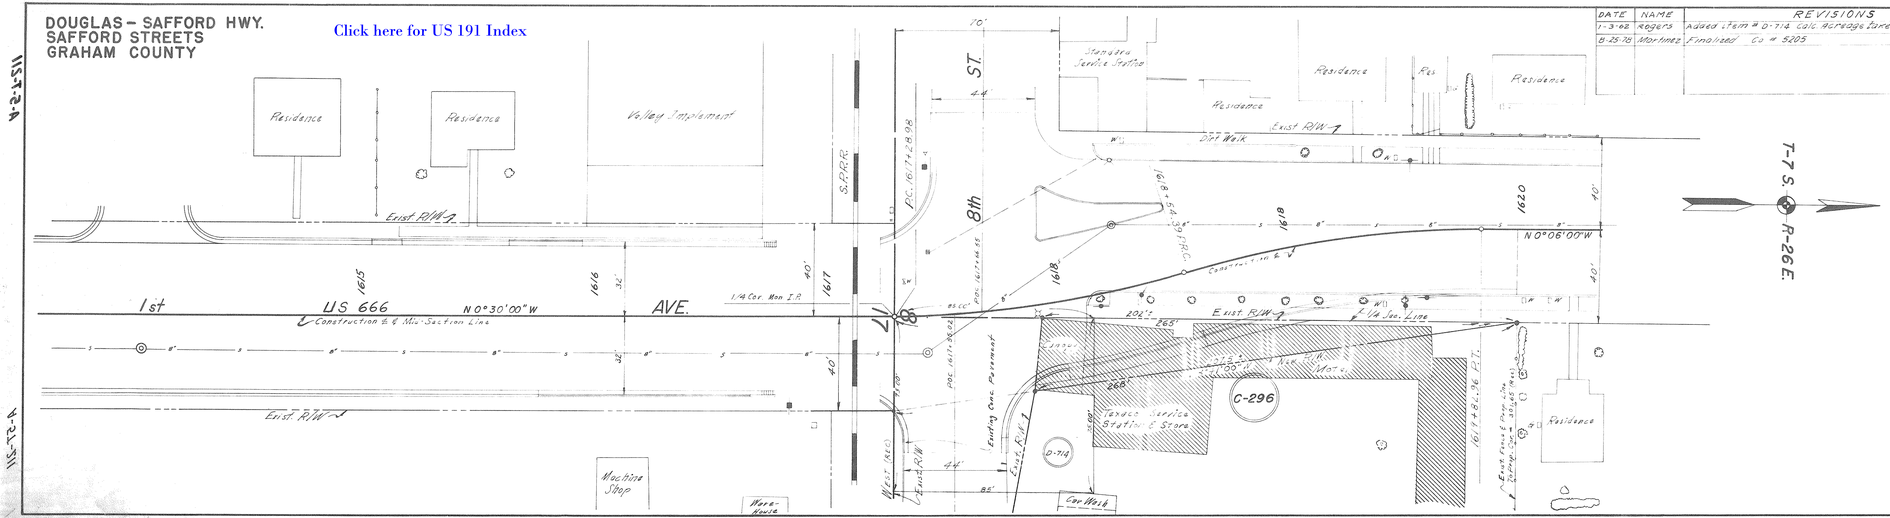

DATE	NAME	REVISIONS
1-3-62	Rogers	Added item # D-714 Calc. Acreage taken & Remaining.
8-25-78	Martinez	Finalized Co # 5205

OWNERSHIP RECORD

ITEM	OWNER	DESCRIPTION	AREA TAKEN	AREA REMAINING	DATE PURCHASED
~~C-296~~	~~JESSE E. GEVA TAYLOR~~	~~[illegible]~~	~~[illegible]~~		
~~D-714~~	~~CEVAR & MAUD TAYLOR~~	~~[illegible]~~	~~[illegible]~~	~~[illegible]~~	

Note:
Parcels C-296 & D-714 are now combined into 5-003. Jesse E. Taylor is now the owner.

This Map is superceded by Drawing No. D-5-T-217

ARIZONA HIGHWAY DEPARTMENT
RIGHT OF WAY DIVISION

RIGHT OF WAY MAP OF
DOUGLAS – SAFFORD HWY
SAFFORD STREETS

STATE PROJECT NON S-207-502
FROM STATION 1615+00 TO STATION 1620+00
GRAHAM COUNTY

ALIGNMENT AND RIGHT OF WAY WIDTHS APPROVED IN ACCORDANCE WITH HIGHWAY PLANS
DATE: _____ ASSISTANT STATE ENGINEER

APPROVED IN ACCORDANCE WITH RESOLUTION DATED _____ 19__ MINUTES OF THE ARIZONA HIGHWAY COMMISSION.

DRAWN BY	B. LENDRIET
DATE	1-31-61
SCALE	1" = 20'
CHECKED BY	
AFE NO.	6666
DRAWING NUMBER	A-5T-211

11S-T-2-A