FED ROAD DIVISION	STATE	PROJECT NUMBER	SHEET NUMBER	TOTAL SHEETS	FINALIZED PLANS
7	ARIZ	F-022-3-722	1	3	

DRAWING NUMBER	D-4-T-339

STATE OF ARIZONA
STATE HIGHWAY DEPARTMENT

RW/PLANS FILE SET

FINALIZED

RW/PLANS FILE SET

RIGHT OF WAY PLAN OF THE

PHOENIX – GLOBE

STATE HIGHWAY

PROJECT NO. F-022-3-722

GILA

COUNTY

Click here for US 60 Index

Approved for R/W requirements in accordance with Roadway plans

J. B. Mertz 4-12-72
DEPUTY STATE ENGINEER DATE

4-17-72
CHIEF DEPUTY STATE ENGINEER DATE

Appraisals and acquisition to be performed by the City of Globe, with exception of Parcel 4-129.

ARIZONA STATE HIGHWAY COMMISSION
Approved for Right of Way Acquisition of Parcel 4-129 in accordance with Resolution Number 72-29 dated 4-7-72
Wm N. PRICE State Highway Engineer

CONVENTIONAL SIGNS

HIGHWAY CENTER LINE (Level)
HIGHWAY R/W LINE (Existing) (Proposed)
CONTROLLED ACCESS (Proposed) (Existing)
C. R. R/W COMMON TO HIGHWAY R/W (Existing)
R. R. R/W LINE
TOWNSHIP AND RANGE LINE
SECTION LINE
1/4 LINE OR MID-SECTION LINE
1/16 LINE
PROPERTY LINE (not part of a Subdivision)
SUBDIVISION OR LOT LINE
ORIGINAL LOT LINE
STATE AND NATIONAL BOUNDARIES
COUNTY LINE
CITY LIMITS
LAND GRANTS BOUNDARIES

FOREST, NATIONAL MONUMENTS,
MILITARY BASES AND INDIAN RESERVATION
SURVEY MEANDER LINE
NEW R/W CONTROL POINT
EXISTING R/W MARKER
PARCEL NUMBER 7-001

RAILROAD TRACK
POWER LINE
POWER TRANSMISSION LINE
TELEPHONE LINE
COMBINATION TELEPHONE AND POWER LINE
UNDERGROUND TELEPHONE CABLE T T
WATER LINE W 2"
GAS LINE G 2"
SEWER LINE (Show size of line in alternate spaces) S 2"
STORM DRAIN SD 2"
CHAIN LINK FENCE

BARBED WIRE FENCE (coil cut type) Gate
STREET LIGHT on extended arm
WATER METER
WATER VALVE
DOWN GUY
FIRE HYDRANT
GAS METER
GAS VALVE
MANHOLE (existing)
ROAD (existing)
PROPERTY ANCHOR BARS
PROPERTY LIMITS ARROWS
CANAL, CHANNEL OR DITCH
BRIDGE
BOX CULVERTS
CATTLE GUARD
RIVER
PIPE CULVERTS (New) (Existing)
DYKE

PHOENIX - GLOBE HWY.
BROAD STREET BOX CULVERT
GILA COUNTY

Click here for US 60 Index

REVISIONS					
C.O. No.	DATE	BY	DESCRIPTION	PROJECT NO.	F-022-3-722
3258	3-24-72	DWS	Par. 4-129: Changed Net Area to Easement.	DRAWING NO.	D-4-T-339
"	"	"	& Name of Owner.	SHEET NO.	2 of 3
"	4-11-72	B.J.N.	Par. 4-129-1 Added & Changed Note (D.E.)	DRAWN BY	E. j. toscano
4279	6-12-75	D.V.H.	*As Built" Finalization	DATE COMP.	12-11-70
				SCALE	None

OWNERSHIP RECORD										ACQUISITION RECORD				
PARCEL NUMBER	OWNER	DESCRIPTION	TOTAL AREA	AREA REQUIRED: GROSS INCLUDING EXISTING R/W	AREA REQUIRED: NET EXCLUDING EXISTING R/W	EASEMENT AREA	REMAINDER: LEFT	REMAINDER: RIGHT	SHEET NUMBER	COMMISSION APPROVAL	TYPE & DATE OF INSTRUMENT	RECORDED: DATE	RECORDED: BOOK	RECORDED: PAGE
~~4-126~~	City of Globe Municipal Corp.	Part of Lot 5, BLK. 89 "GLOBE TOWNSITE" Sec. 25, T.1N. R.15E.	76¢		76¢	Deleted			3	①	—	—	—	—
~~4-127~~	Nick Vitkovich, widower	Part of Lot 5, BLK. 89 "GLOBE TOWNSITE" Sec. 25, T.1N. R.15E.	6650¢		2282¢	Deleted		4368¢	3	①	—	—	—	—
~~4-128~~	U.C. & Irene Gutierrez, h/w	Part of Lot 6, BLK. 89 "GLOBE TOWNSITE" Sec. 25, T.1N. R.15E.	15674¢		410¢	Deleted		15,264¢	3	①	—	—	—	—
* 4-129	Ruth B. Sachs, et al	Part of Lot 1, BLK. 90 "GLOBE TOWNSITE" Sec. 25, T.1N. R.15E.	34200¢		~~742¢~~	742¢		33458¢	3	6-16-72	DED 4-27-72	8-21-72	326	205
4-129-1	City of Globe Municipal Corp.	Part of Lots 5 & 6 BLK. 89 "GLOBE TOWNSITE" Sec. 25, T.1N. R.15E.				T.C.E. Only 4927.50¢			3	6-16-72	T.C.E. 5-1-72	—	—	—

① Owned or acquired by the City of Globe and covered by the T.C.E. granted to A.D.O.T. under Parcel No. 4-129-1 by the City of Globe.

*NOTE: Parcel to be acquired by A.H.D. as D.E. and subsequently quit-claimed to City of Globe for future maintenance and responsibility.

PHOENIX - GLOBE HWY.
BROAD STREET BOX CULVERT
GILA COUNTY

REVISIONS					
				PROJECT NO.	F-022-3-722
3238	3-24-72	DWS	Par. 4-129, Changed New R/W to D.E. & Added Notes on All Parcels.	DRAWING NO.	D-4-T-339
"	"	"		SHEET NO.	3 of 3
"	4-11-72	B.J.N.	Added Par. 4-129-1, T.C.E. Callout, Zip & Note.	DRAWN BY	E. j. toscano
4279	6-12-75	D.J.H.	"As Built" Finalization	DATE COMP.	12-11-70
				SCALE	1" = 20'

Click here for US 60 Index

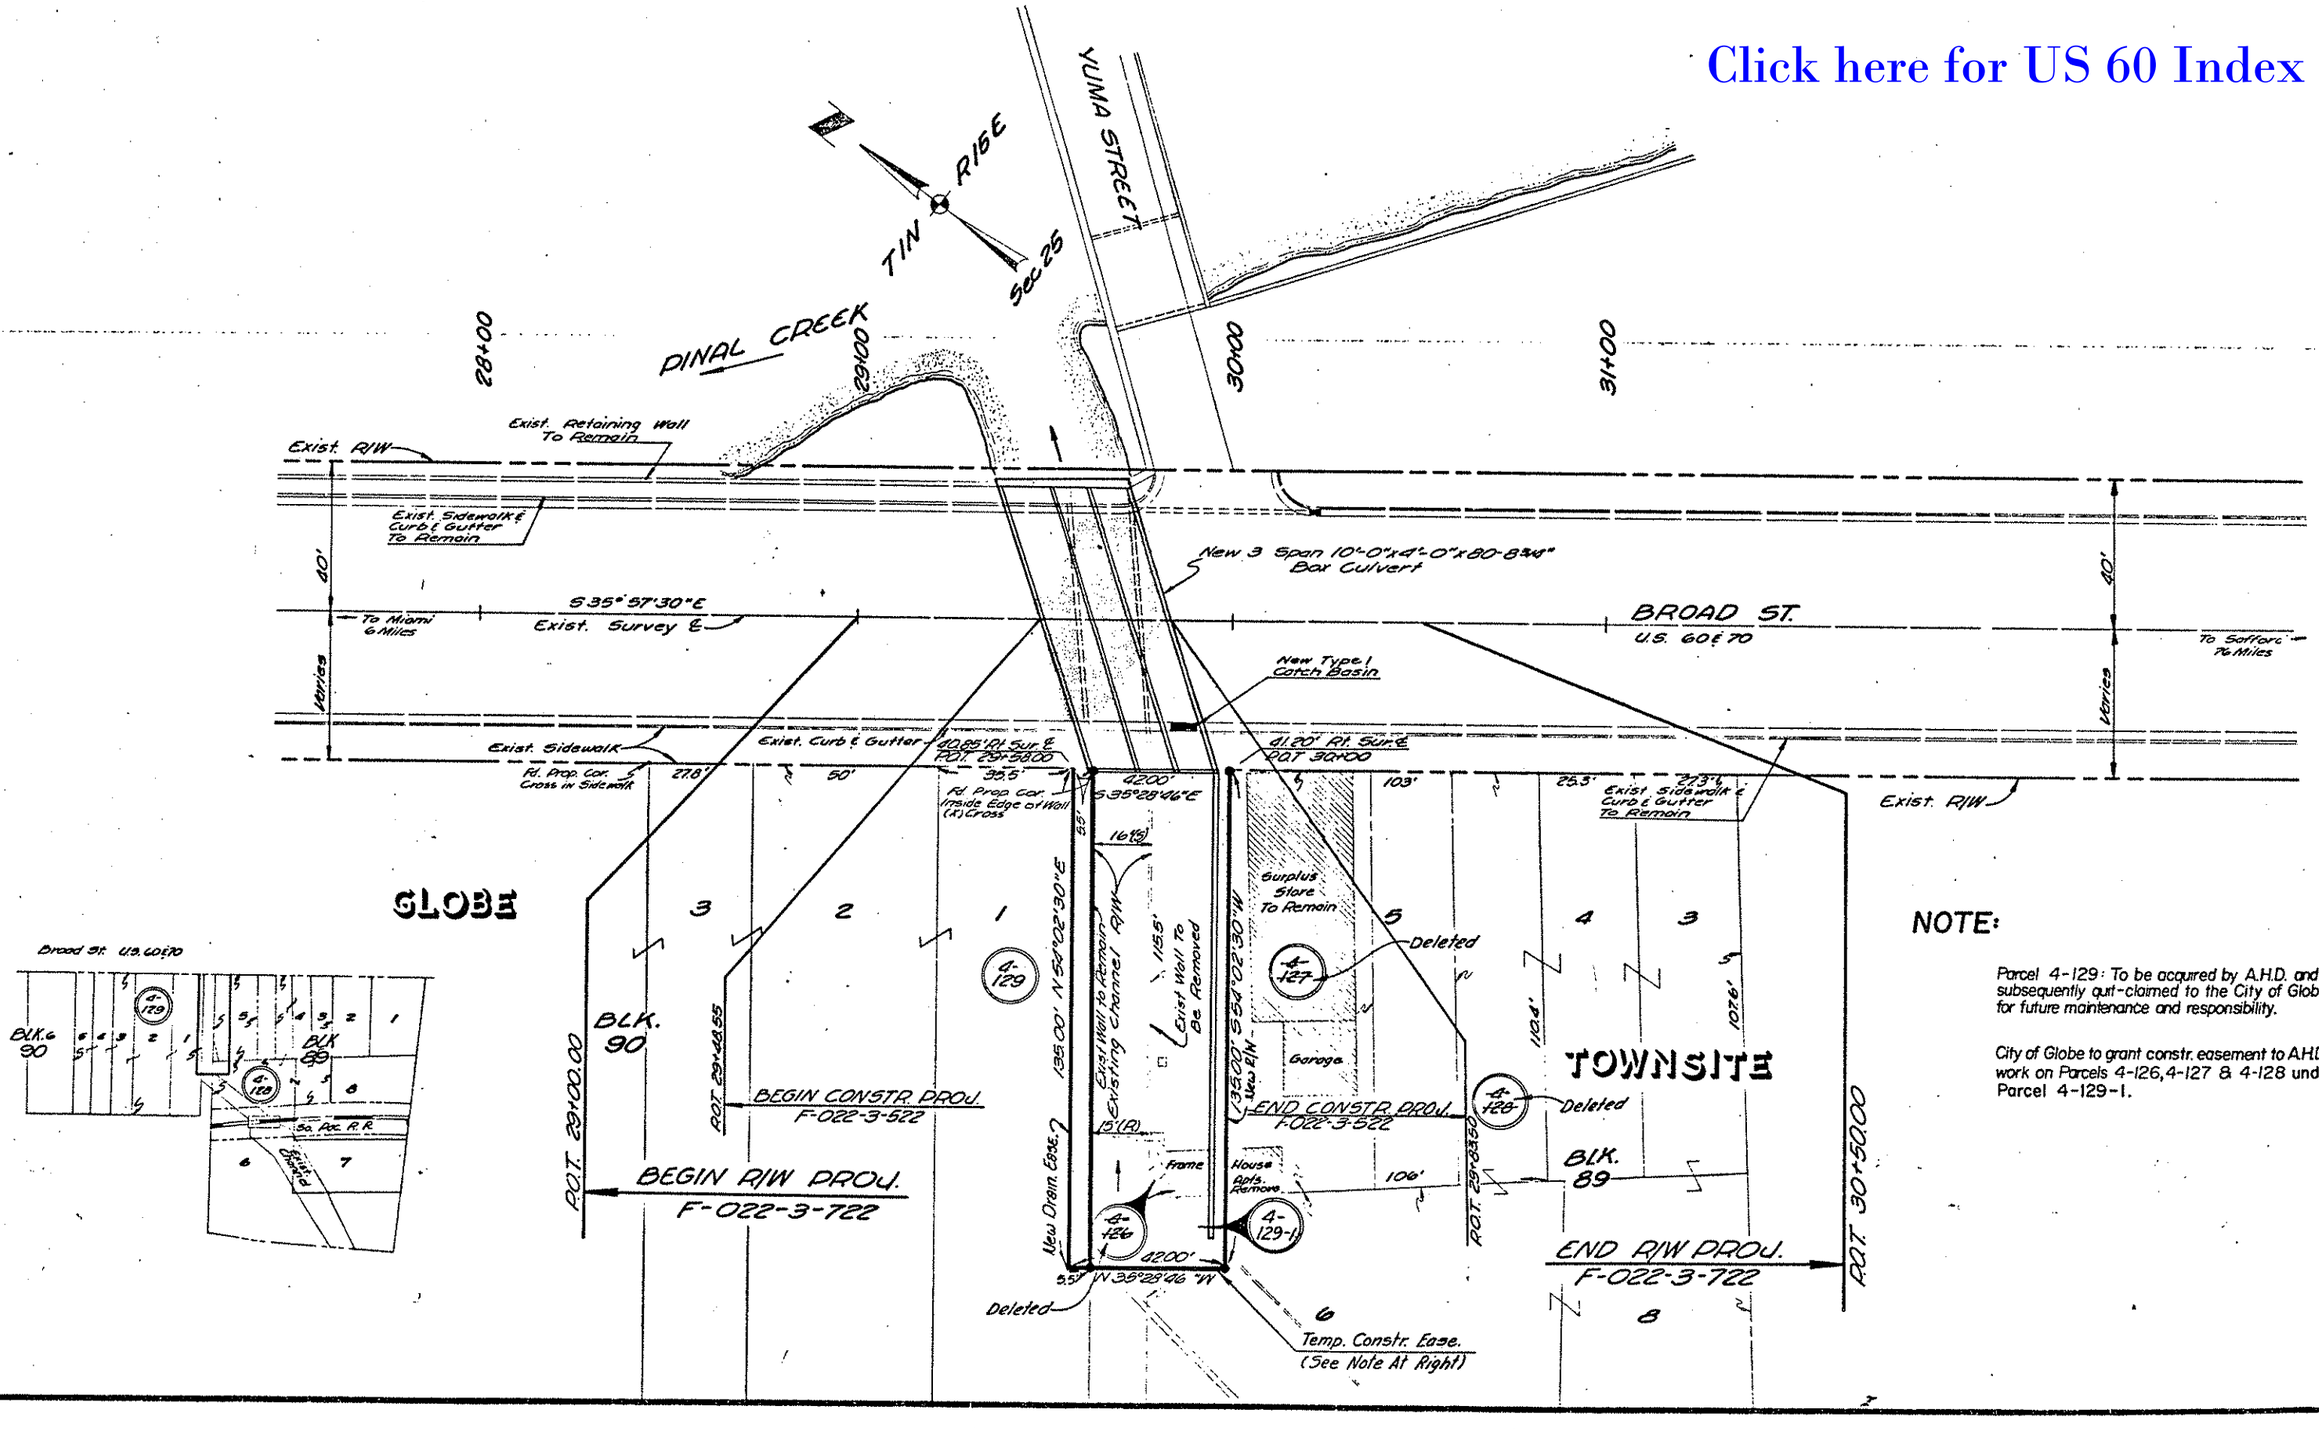

NOTE:

Parcel 4-129: To be acquired by A.H.D. and subsequently quit-claimed to the City of Globe for future maintenance and responsibility.

City of Globe to grant constr. easement to A.H.D. for work on Parcels 4-126, 4-127 & 4-128 under Parcel 4-129-1.

CHECKED BY Ralph L. Robinson

HARD COPY 7065 TI