F.H.W.A. REGION	STATE	PROJECT NO.	SHEET NO.	TOTAL SHEETS	FINALIZED PLANS
9	ARIZ.	F-022-3-860	1	4	

8815

STATE OF ARIZONA
DEPARTMENT OF TRANSPORTATION
HIGHWAYS DIVISION

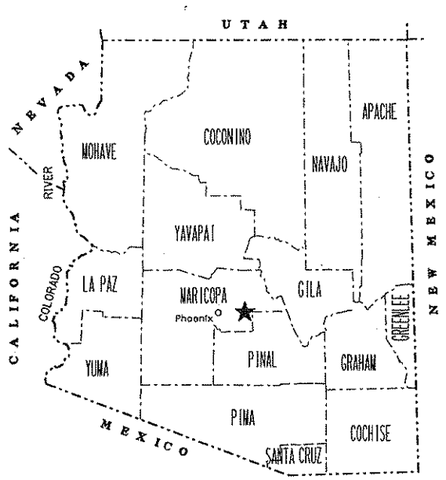

RIGHT OF WAY PLAN OF THE
PHOENIX - GLOBE HWY (U.S. 60)
TOMAHAWK RD. INTERSECTION
60 PN 197 H 2276 01R
F-022-3-860

LENGTH OF PROJECT .51 DISTRICT I

Click here for US 60 Index

R/W PLANS FILE SET

R/W PLANS FILE SET

R/W PLANS FILE SET

R/W PLANS FILE SET

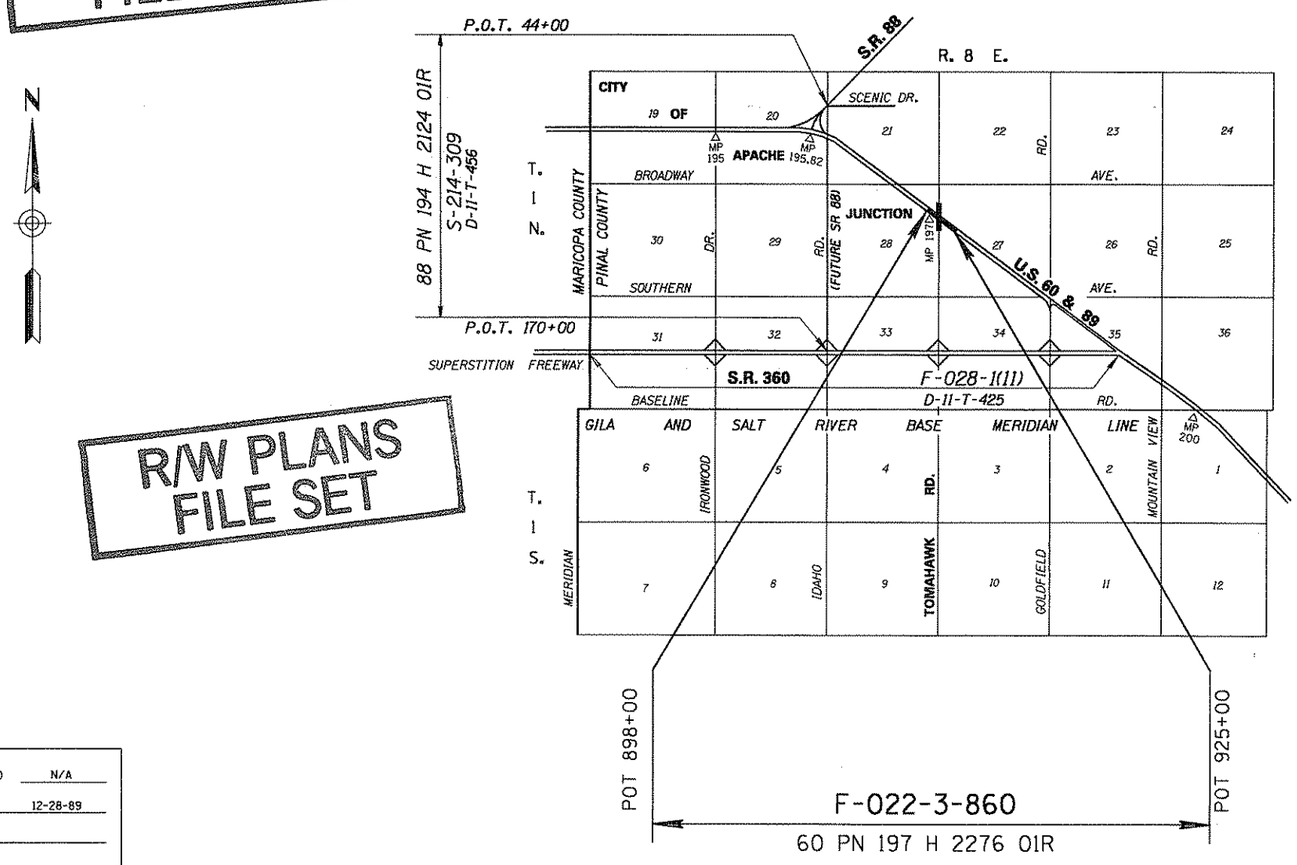

PUBLIC HEARING REQUIREMENTS CERTIFIED	N/A
ENVIRONMENTAL CLEARANCE	12-28-89
C & S REVIEW	
BID SET REVIEW	

ARIZONA DEPARTMENT OF TRANSPORTATION BOARD
APPROVED FOR RIGHT OF WAY ACQUISITION IN ACCORDANCE
WITH RESOLUTION 90-01-A-05 DATED 1-12-90
THOMAS A. BRYANT, II STATE ENGINEER

APPROVED IN ACCORDANCE WITH ROADWAY PLANS
DATE 3/9/90

DEPUTY STATE ENGINEER
Robert P. Nicholson

U. S. DEPARTMENT OF TRANSPORTATION
FEDERAL HIGHWAY ADMINISTRATION

APPROVED DATE

DIVISION ADMINISTRATOR

DRAWING NO. D-11-T-453
SHEET NO. 1 OF 4

Click here for US 60 Index

① AREA INCLUDES 9463Φ ESMT. BY PATENT
② AREA INCLUDES 1336Φ ESMT BY PATENT
③ AREA INCLUDES 1122Φ ESMT BY PATENT

OWNERSHIP RECORD / ACQUISITION RECORD

PARCEL NUMBER	OWNER	DESCRIPTION	TOTAL AREA	AREA REQUIRED: GROSS INCLUDING EXISTING R/W	AREA REQUIRED: NET EXCLUDING EXISTING R/W	EASEMENT AREA	REMAINDER: LEFT	REMAINDER: RIGHT	SHEET NO.	CHIEF R/W AGENT APPROVAL	INSTRUMENT: TYPE	INSTRUMENT: DATE	RECORDED: DATE	RECORDED: DOCUMENT
11-362	AM VETS POST #2	PT SE ¼ NE ¼, SEC. 28, T. 1 N., R. 8 E.	16292Φ		16292Φ				3					
11-415	GEORGE M. PIPPETT, et ux	PT SE ¼ NE ¼, SEC. 28, T. 1 N., R. 8 E.	40000Φ		715Φ			39285Φ	3					
11-416	WILLIAM PRICE	PT NE ¼, SEC. 28, T. 1 N., R. 8 E.	208646Φ			~~D.E. 40000Φ~~ D.E. 43130Φ	~~168646Φ~~ 165516Φ		3					
11-417	MARGARET E. CRAWFORD	PT SW ¼ NW ¼, SEC. 27, T. 1 N.,R. 8 E.	56258Φ		① 13490Φ	~~4000~~ T.C.E. 4800Φ		42768Φ	3					
11-418	ALINE M. CAUGHEY	PT SW ¼ NW ¼, SEC. 27, T. 1 N.,R. 8 E.	147281Φ		③ 5611Φ		141670Φ		3					
11-419	MARGARET E. CRAWFORD	PT SW ¼ NW ¼, SEC. 27, T. 1 N.,R. 8 E.	356433Φ		② 1473Φ		354960Φ		3					
11-420	THUNDERBIRD JVENTURE	PT SE ¼ NE ¼, SEC. 28, T. 1 N., R. 8 E.	528597Φ		15239Φ			513358Φ	3					
11-420-L-1	GEORGE J. HARSTINE, et al	PT SE ¼ NE ¼, SEC. 28, T. 1 N., R. 8 E.	480543Φ		15239Φ			465304Φ	3					
11-483	ROBERT L. BEEMAN, et al	PT SE ¼ NE ¼, SEC. 28, T. 1 N., R. 8 E.	~~793718~~ 525913Φ		28985Φ	~~D.E. 28985Φ~~		~~764733~~ 496928Φ	3					
11-484	P & F PROPERTIES	PT SE ¼ NE ¼, SEC. 28, T. 1 N., R. 8 E.	~~35398~~ 337451Φ			D.E. 2465Φ		~~32933~~ 334986Φ	3					

REVISIONS

C.O. NO.	DATE	BY	DESCRIPTION
8283	12-20-90	GRJ	REV'D D.E. AREA TO R/W, PAR. 11-483
8300	2-1-91	LD	REV'D OWNER NAME PAR. 11-420-L-1
8352	5-24-91	HWT	REV'D OWNER NAME PAR. 11-420

REVISIONS

C.O. NO.	DATE	BY	DESCRIPTION
8140	5-2-90	NRG	ADDED PARS 11-483 & 11-484, REV'D NOTES
"	"	"	1 & 2 & ADDED NOTE 3.
8153	5-21-90	NRG	REV'D D.E. & REM. PAR. 11-416.
8153	5-21-90	JCH	REV'D TOT,REM PAR 11-483 & PAR 11-484
8178	7-9-90	KJW	REV'D T.C.E. AREA, PAR. 11-417.
8241	10-2-90	LD	REV'D OWNER NAME PAR. 11-419

DRAWING NO.	D-11-T-453
HARD COPY	
COUNTY	PINAL
DRAWN	KURT J WILLIAMS
CHECKED	JIM HAVINS
SCALE	
ROUTE	
LOCATION	TOMAHAWK RD. INTERSECTION

ARIZONA DEPARTMENT OF TRANSPORTATION
HIGHWAYS DIVISION
RIGHT OF WAY PLANS SERVICES

HIGHWAY: PHOENIX - GLOBE HWY.
PROJECT NO. F-022-3-860

*****DGN*SPECIFICATION***** VIEW NAME>
*****SYSTIME*****

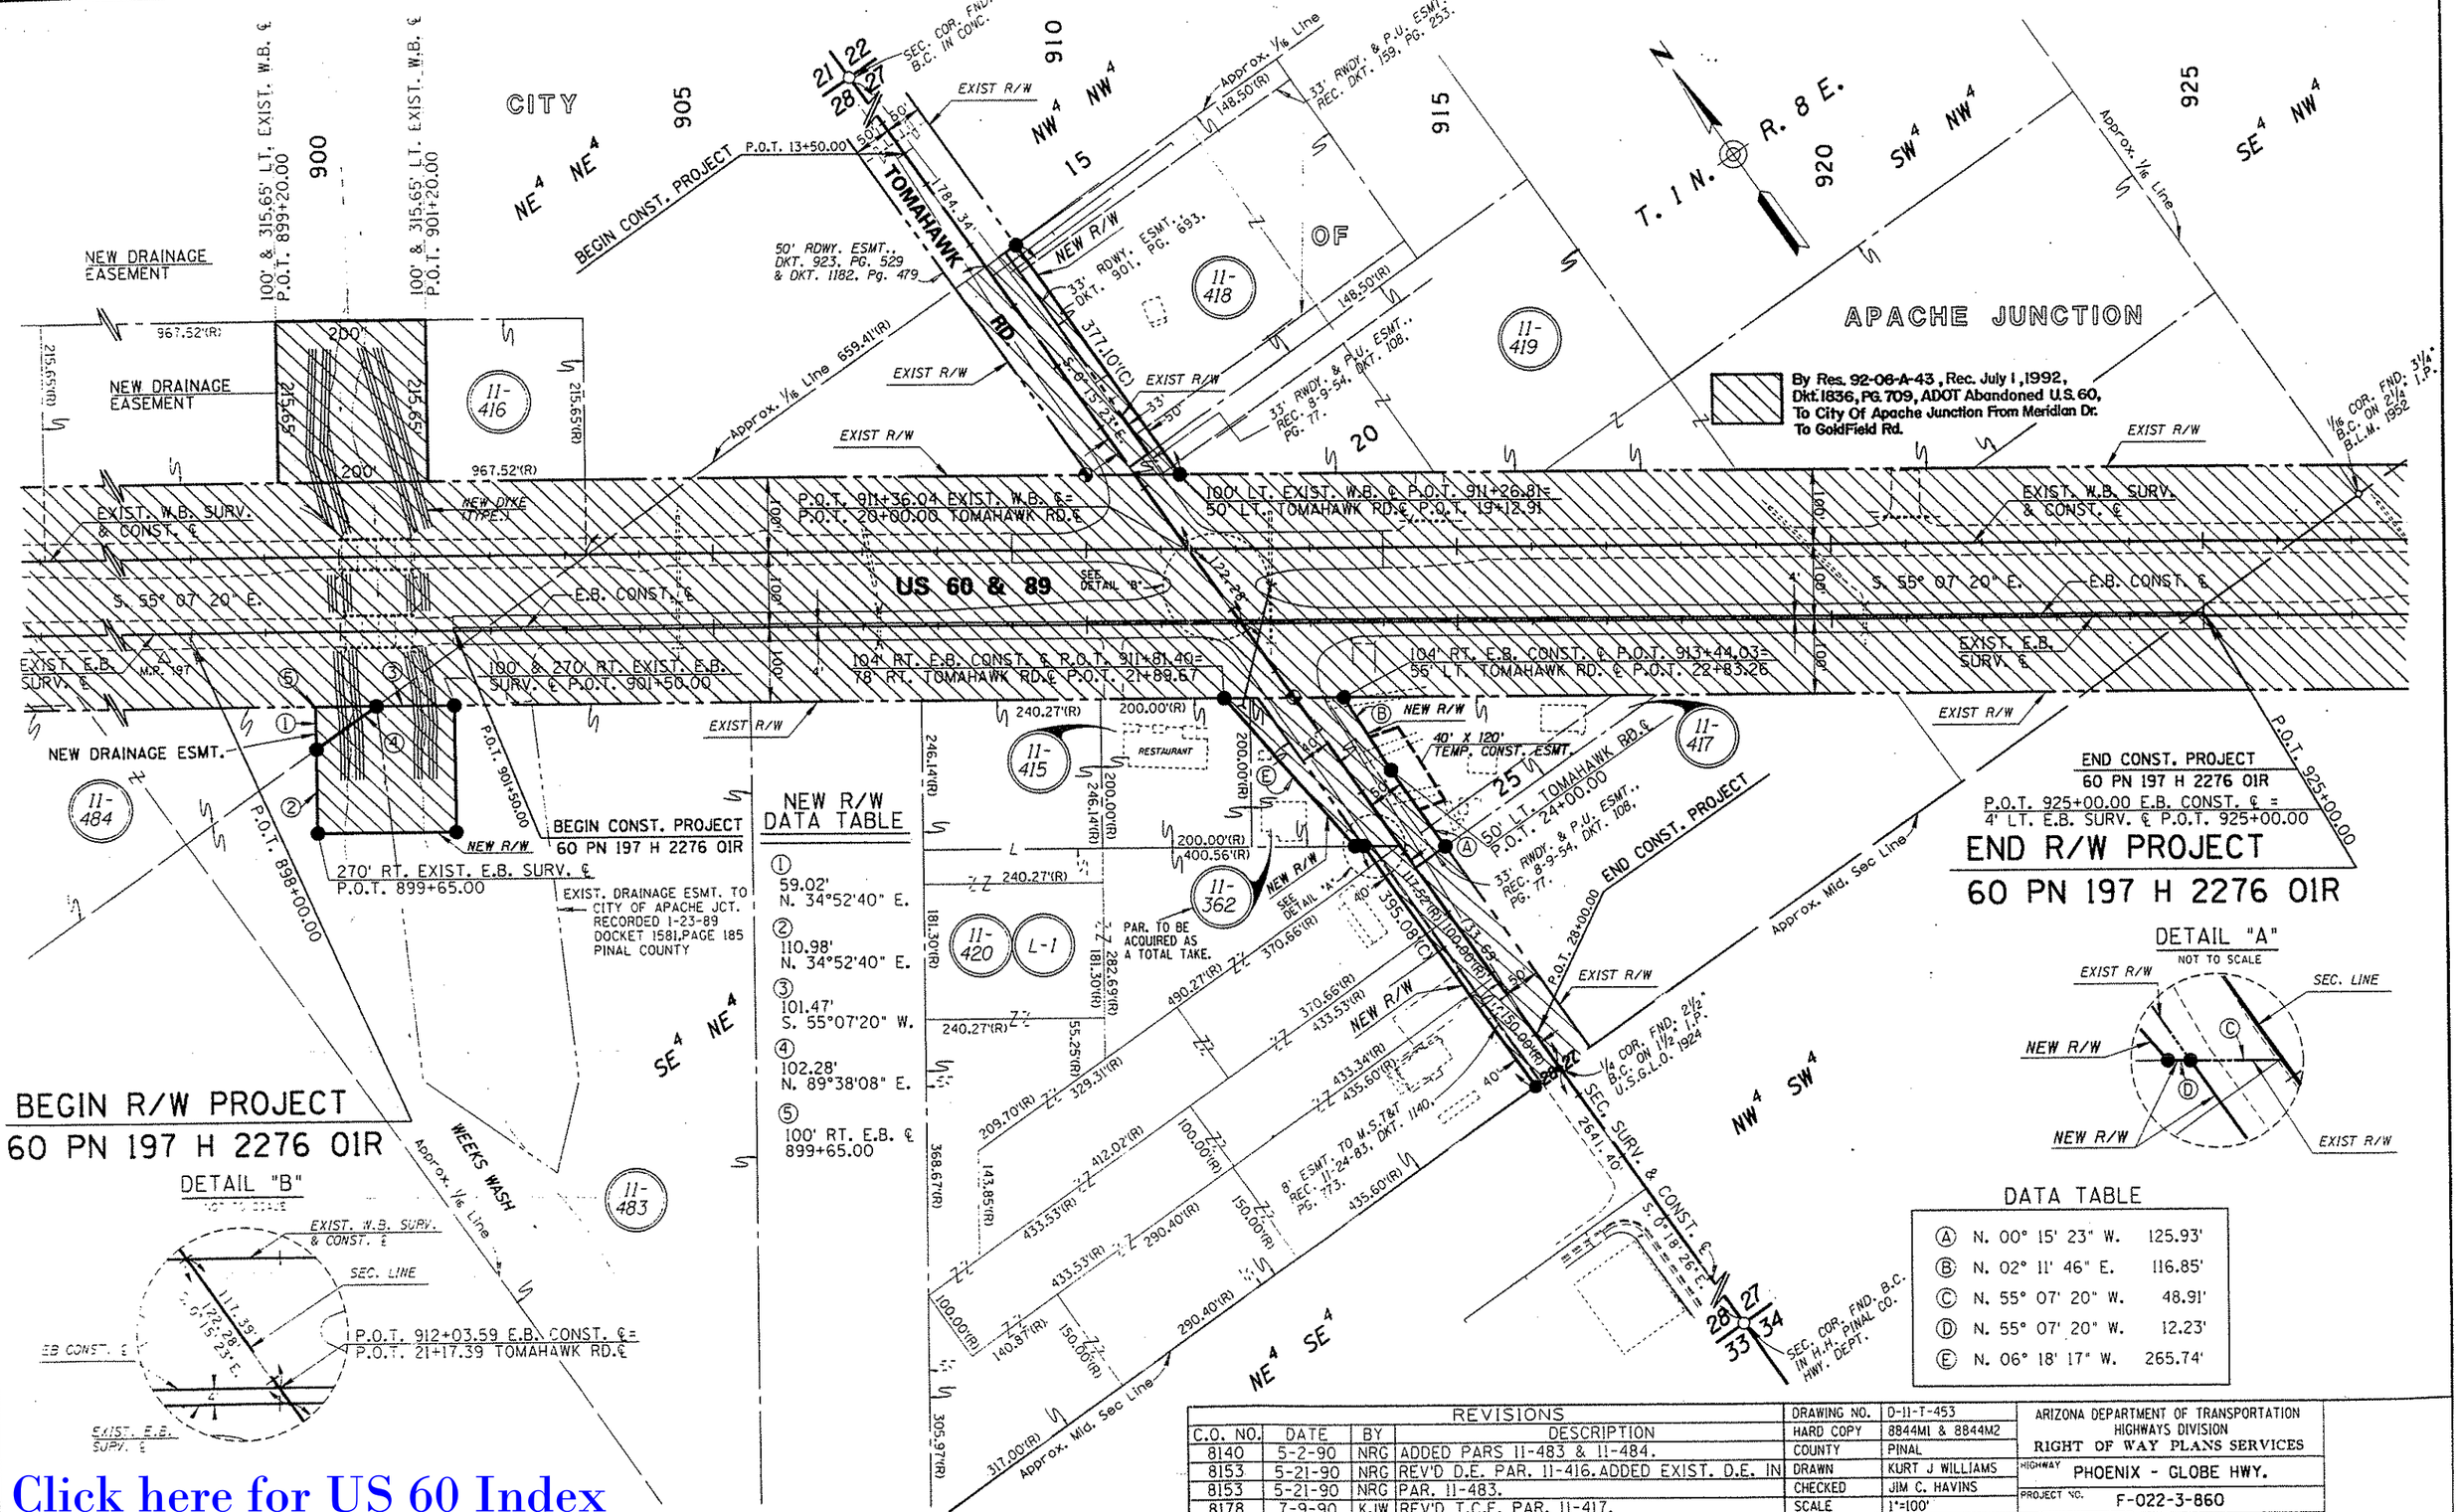

Click here for US 60 Index

REVISIONS				
C.O. NO.	DATE	BY	DESCRIPTION	
8140	5-2-90	NRG	ADDED PARS 11-483 & 11-484.	
8153	5-21-90	NRG	REV'D D.E. PAR. 11-416. ADDED EXIST. D.E. IN	
8153	5-21-90	NRG	PAR. 11-483.	
8178	7-9-90	KJW	REV'D T.C.E. PAR. 11-417.	
8283	12-19-90	GRJ	REV'D D.E. PAR. 11-483 TO NEW R/W	
8793	12-27-93	RCO	ADDED ABANDONMENT NOTE AND ZIPPED AREA: PERFORMED BY DMJM ARIZONA, INC.	

DRAWING NO.	D-11-T-453
HARD COPY	8844M1 & 8844M2
COUNTY	PINAL
DRAWN	KURT J WILLIAMS
CHECKED	JIM C. HAVINS
SCALE	1"=100'
ROUTE	US 60
LOCATION	TOMAHAWK RD INTERSECTION

ARIZONA DEPARTMENT OF TRANSPORTATION
HIGHWAYS DIVISION
RIGHT OF WAY PLANS SERVICES

HIGHWAY: PHOENIX - GLOBE HWY.

PROJECT NO. F-022-3-860

SHEET 3 OF 4

TRACS NO. 60 PN 197 H 2276 01R

___ OF ___

ZF1:(45.1)60RW197.S01:1
12-MAR-1991 20:36
<NEW NAME>