Click here for US 66 Index

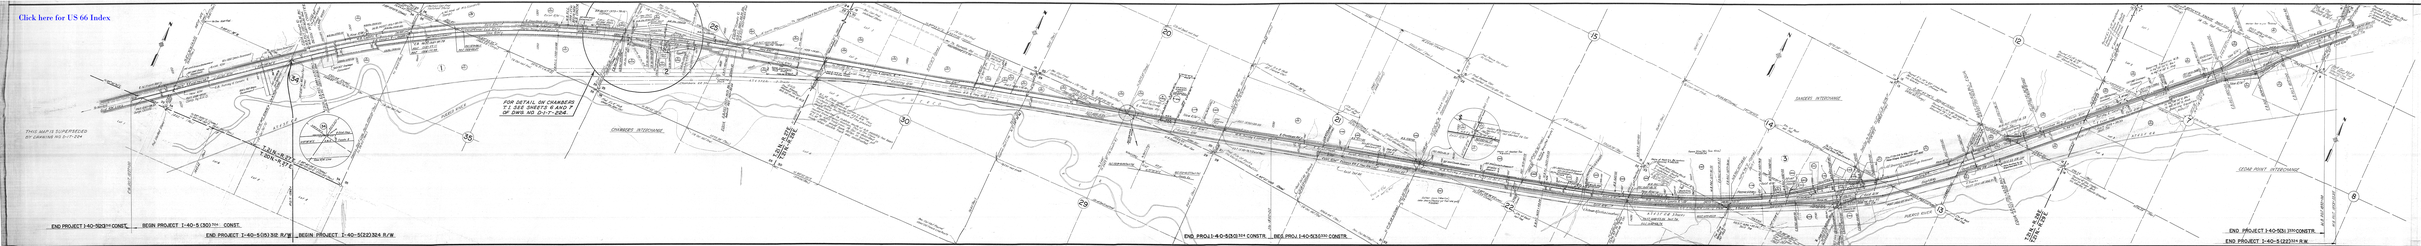

## CURVE DATA

| | 1 | | 2 | | 3 | |
|---|---|---|---|---|---|---|
| | E.B.(OFF. LOC.) | W.B.(OFF. LOC.) | E.B.(OFF. LOC.) | W.B.(OFF. LOC.) | E.B.(OFF. LOC.) | W.B. |
| Δ | 17°00'30" RT. | 17° 37' 05" RT. | 6°56' 30" RT. | 6°19' 55" RT. | 29° 26' 30" LT. | 29°26'30" LT. |
| D | 0° 15'04.3" | 0° 15' 07.08" | 0°09' 01.53" | 0°08' 19.7" | 0° 13' 59.706" | 0° 14' 03.413" |
| R | 22,808.32' | 22,916.32' | 38,089.20' | 41,275.85' | 24,563.97' | 24,455.97' |
| T | 3410.42' | 3551.33' | 2310.17' | 2283.09' | 6453.784' | 6425.409 |
| L | 6770.68' | 7046.61' | 4614.69' | 4561.53' | 12,622.29' | 12,566.80' |

## OWNERSHIP RECORD

| ITEM | OWNER | DESCRIPTION | ACREAGE TAKEN | ACREAGE REMAINING | DATE PROPERTY ACQUIRED |
|---|---|---|---|---|---|
| D-1020 | Charles G. Grimes | NE¼ Sect. 34, T21N R27E | 10.2 ± | 133.3 ± | |
| D-1021 | Clifford L. & Eleanor M. Wolfswinkel, H/W | Part of Sect. 35, T21N R27E | 3.92± | 87.65± | |
| | | W½, Pt. S½ SE¼, Pt. S½ N½ SE¼, Sect. 26 T21N R27E | 9.68± | 364.43± | |
| D-1022 | Thomas E. & Loretto Minyard, H/W | Parcel In Sect. 26, T21N R27E | 0.05± | 36.55± | |
| D-1023 | Sam Day III & Dolores Day, H/W | Parcel In Sect. 26, T21N R27E | 0.10± | 1.35± | |
| D-1024 | Frank J. & Alice Young, H/W | Sect. 25 (less exceptions) T21N R27E | 22.70± STOCK PILE 6.70 AC. | 505.62± | 9-7-62 |
| D-1025 | Atchison Topeka & Santa Fe Railway | Parcel In SW¼ Sect. 25, T21N R27E | 2.25± | 9.18± | |
| D-1026 | Mary A. Barber | Lot #1, Lot #2, SE¼ NW¼, S½ NE¼ NW¼ Sect. 30, T21N R28E | 6.62A.± | 101.97± | |
| D-1027 | F.V. & Mary A. Barber, H/W | Pt. NE¼ Sect. 30, T21N R28E | 3.25± | 26.58± | |
| D-1028 | Douglas C. Norris & Inez S. Norris, H/W Paul S. Rooks & Garnett M. Rooks, H/W | Pt. NE¼ Sect. 30, T21N R28E | 1.17± | 6.66± | |
| D-1029 | John A. Woods, Mary A. Barber, Frank A. Woods, Hrs. to Est. of Geo. S. & Dora Woods | Pt. NE¼ Sect. 30, T21N R28E | 0.015 | 0.083 | |
| D-1030 | Lawrence E. Woods | Pt. Sect. 30, T21N R28E | 1.27 | 6.18 | |
| D-1031 | Ray T. & Maria W. Grimes, H/W | Pt. Sect. 30, T21N R28E | 0.97 | 3.57 | |
| | | Parcel In Sect. 29, T21N R28E | 3.66± | 4.98± | |
| D-1032 | Frank A. Woods, John A. Woods & Mary A. Barber | Pt. of Sect. 29, T21N R28E | 3.13± | 10.87± | |
| D-1033 | William C. & Joanna H. McDonald, H/W | Parcel #1, SW¼ Sect. 20, T21N R28E | 0.35± | 39.65± | |
| | | Parcel #2 Parcel In SW¼ SE¼ Sect. 20, T21N R28E | 1.08± | 0.57± | |
| D-1034 | Peter Balcomb, Etux. | Pt. W½ SE¼ Sect. 20, T21N R28E | ~~1.10±~~ 1.36± | ~~29.90±~~ 29.61± | |
| D-718 | Forrest Leonard & Mary Mae Looney, H/W | E½ SE¼ Sect. 20, T21N R28E Except NE¼ SE¼ SE¼ | | | |
| D-499 | Tom Pelton | Pt. of Sect. 21, T21N R28E, N. of RR. | 8.14± | 105.02± | 8-17-62 |
| D-500 | E.O. & Maude Eddens, H/W | Pt. of Sect. 21, T21N R28E, N. of RR. | 6.16 | 157.24 | 8-17-62 |
| D-501 | Esther Lewis (Martin) Jake Lewis (Hasko-ye-Tah-da-yah) | NW¼ NW¼ Sect. 22, T21N R28E (Indian Allotment) #010041 | .09± | 35.85± | |
| D-502 | Heirs of Hoston-Tso | NW¼ Sect. 22, T21N R28E (Indian Allot #010043) | 7.17 | 146.24 | |
| D-503 | Ja-Holy-Bega (Pat Murphy) | SW¼ NE¼ NW¼ SE¼, Sect. 22, T21N R28E Indian Allotment (May have Sold 1A± to Hasko Cronemeyer for Highway Access) #010316 | 3.05 | 63.17 | |
| D-504 | ARIZONA HIGHWAY DEPARTMENT | SW¼ NE¼ NE¼ & Pt. of NW¼ SE¼ NW¼, N of Hwy. 66, Sect. 22, T21N, R28E | 2.19 | 8.33 | |
| | | NE¼ SE¼ SE¼, Sect. 20, T21N R28E | 0.58± | 9.42 | |
| | | Parcel In SE¼ Sect. 14, T21N R28E | 0.41± | 3.60± | |
| D-505 | Frank D. & Helen R. Mann | E¼ NE¼, Sect. 22, T21N R28E | 2.40 | 51.93 | 7-16-62 |
| D-506 | Heirs of Hash-kin Be-esdzen (or Tannie) | NW¼ NE¼ N½ NW¼ SW¼ NW¼ (Indian Allot.) Sect. 23, T21N R28E #042351 | 7.00 | 116.98 | |
| D-507 | Fannie Slim/Mrs. Tom Slim) | SW¼ Sect. 14 T21N R28E (Indian Allot. #010034 | 2.17± | 153.55± | |
| D-508 | R.P. DeGrothenreid | SE¼ SE¼ Sect. 14 NW of Chefa Station Grounds, T21N R28E | 0.27± | 0.03± | |
| D-509 | A.T. & S.F. R.R. | Pt. of Sect. 13, T21N R28E | .55± | | |
| | | Pt. of Sect. 14, T21N R28E | 2.34± | | |
| D-510 | C.A. McCarrell | Parcel In SE¼ Sect. 14, T21N R28E | 0.90 | 0.03 | NOTIFIED TO VACATE |
| D-511 | Spencer Balcomb, Jr. & Donna Balcomb, H/W | Parcel In SE¼ Sect. 14, T21N R28E | 0.12± | None | 10-2-62 |
| | | Parcel In SE¼ Sect. 14, T21N R28E | 0.56± | 1.83 | " " |
| | | Parcel In SE¼ Sect. 14, T21N R28E | 0.04± | 0.51± | " " |

## OWNERSHIP RECORD

| ITEM | OWNER | DESCRIPTION | ACREAGE TAKEN | ACREAGE REMAINING | DATE PROPERTY ACQUIRED |
|---|---|---|---|---|---|
| D-513 | Marvin E. Porter & Lavina M. Porter ½ | Parcel in NE¼ SE¼, Sec. 14, T.21N.-R.28E. | 1.32 ± | 0.09± | 7-16-62 |
| D-514 | Puerco School Dist. No. 18 | Parcel In SE¼, Sect. 14, T21N R28E | 0.32± | 4.84± | AUTH. TO CONDEM. |
| | | Parcel In SW¼, Sect. 13, T21N R28E | 0.48± | 2.04± | " " |
| D-516 | Lynn S. & Mabel Helgquist, H/W | Parcel In SW¼ Sect. 13, T21N R28E | 1.14± | 0.04± | |
| D-517 | J.J. & Cora Spears Burkett, H/W | Parcel In SW¼ Sect. 13, T21N R28E | 0.19± | 1.86± | 7-30-62 |
| D-518 | A.C. Whiting | Parcel In SE¼ Sect. 14, T21N R28E | 2.54± | 15.06± | AUTH. TO CONT. |
| D-519 | Navajo Indian Reservation | Sect. 12, T21N R28E | 3.85 | 621.59 | 8-17-62 |
| D-520 | Riley McPherson | Sect. 7, N. of A.T. & S.F. RR. R/W, T21N R29E | 17.18 | 290.80 | |
| D-521 | Hoskan-Tsin-a-jini | SE¼, Sect. 6, T21N R29E (Indian Allotment #010062) | 5.19± | 146.99± | |
| D-522 | Corporation of the Presiding Bishop of Church of Jesus Christ of Latter Day Saints | Parcel In SW¼ SE¼ Sect. 14, T21N R28E | 0.08 | 0.92± | |
| D-1063 | Hoska Cronemeyer | Parcel In Sect. 22, T21N R28E #010316 | 0.60 | 0.40 ± | |
| D-512 | C.G. Wallace | 2 Parcels in SE¼, Sec. 14, T21N. R.28E. | 0.18± | None | AUTH. TO CONDEM. |
| | | Tittle Report Policy No 51055-423 | 0.13± | None | |
| | | NE¼ SE¼, Sec. 14, N. of Hwy. 66, T.21N. R.28E | 3.80± | 59.08± | |
| | | NE¼, Sec. 13, N. of Hwy. 66, T.21N. R.28E | 4.86± | | |
| | | W½, Sec. 13, N. of Hwy. 66, T.21N. R.28E | 7.23± | 132.583± | |
| | | 40 A., NE. Cor. Sec. 7, T.21N. R.28E | 1.04± | 36.44± | |
| D-512-1 | C.G. Wallace | NE¼ Sec. 13, NES. of U.S. Hwy. 66, T.21N. R.28E (to be Acquired Non. F.A. | 12.68 | | |
| C-472 | Ariz. Hwy. Dept. (CLINGBERG LAND CAMP.) | Pt. of W½ SE¼, Sec. 20, T.21N.-R.28E. | 1.1± | 11.3± | |
| D-1024-1 | Filtrol Corp. a Delaware Corp. | 50' Road Easement in Sec. 25, T.21N. R.27E. | | | |

## MAP REVISIONS

| DATE | REVISED BY | DESCRIPTION |
|---|---|---|
| 5-14-62 | L. Yup | Moved back control of access & added dimensions. Bearing & Notes on sht. 17. Revised takes on D-512 and Added D-512-1 (12.68± Acres To be Acquired Non F.A.). |
| 6-26-62 | Kowacz | Plotted Item D-1063 |
| 7-12-62 | Jungers, John | Revised Access Control at sta. 1732 |
| 7-17-62 | Kowacz | Correct Item # D-512 in Tittle Block & Made Indian Application |
| 7-25-62 | Jungers, John | Changed size of easements at sta. 1254, 1361 & 1368. |
| 7-31-62 | G.G.H. | Added stock Pile Area sta: 1421+00, |
| 10-19-62 | R. Walley | Corrected Land Tie Mid. Sec. 34. Corrected Take & Remain Item D-1020. |
| 12-13-62 | G.G.H. | ADDED CHAMBERS MAINT. CAMP, CORRECTED AREA OF WILLIS LYNCH, ASO NAMES CHANGED D-1024, "I.S. INDIAN" TO "SAM BALCOMB". |
| 2-26-63 | L. Yup | Added New Slope Easement from Sta. 1719+50 to Sta. 1721+50 Revised Acre Remaining on D-512 W½ Sec. 13, From 132.77± to 132.583 |
| 8-26-63 | Jungers, John | Added Item No. D-1024-1 Change Order No. 66 |
| 12-10-66 | J. Nez | Revised distances and bearings along new R/W and exist. R/W Rt. between P.O.C. 1685+83.26 and P.O.C. 1711+50. Changed acreage taken in Parcel D-509 from 2.40 to 2.34. (Change Order No. 1183) |

THIS MAP IS SUPERSEDED BY DRAWING NO. D-1T-224

SUPERSEDED SEE D-1T-224

Registered Professional Engineer (Civil) Certificate Expires 6-30-63 Gerald Girand 91. 1962 ARIZONA U.S.A.

VT

RIGHT OF WAY

# HOLBROOK-LUPTON HIGHWAY
## INTERSTATE HWY. 40
## Mc CARROLL RANCH-CEDAR POINT SECTION

FEDERAL AID PROJECT I-40-5(30&31) 324const-(22)R/W

FROM STATION 1237+18.50 TO STATION 1852+30.90

APACHE COUNTY

ALIGNMENT, RIGHT OF WAY WIDTHS, AND CONTROL OF ACCESS, APPROVED IN ACCORDANCE WITH HIGHWAY PLANS.

DATE: 7-12-1962 ASSISTANT STATE ENGINEER

APPROVED IN ACCORDANCE WITH RESOLUTION DATED: DEC. 14 1962 MINUTES OF THE ARIZONA HIGHWAY COMMISSION. BY RES. 62-174

CONTROL OF ACCESS SHOWN THUS:

| | |
|---|---|
| DRAWN BY | POP, DH, MM |
| DATE | Nov. 1961 |
| SCALE | 1" = 400' |
| CHECKED BY | |
| A.F.E. NO. | 66730 |
| DRAWING NUMBER | C-1T-224A |

JOHANNESSEN & GIRAND & EARLE V. MILLER CONSULTING ENGINEERS

Click here for US 66 Index