FLAGSTAFF — CAMERON HWY.
FLAGSTAFF DRAINAGE AREAS
COCONINO COUNTY

Click here for US 89 Index

REVISIONS				
CO. NO.	DATE	BY	DESCRIPTION	
5560	4-8-80	J.Mc.	Deleted Parcel 3-197	

FEDERAL NO.	F-037-1-601
DRAWING NO.	D-3-T-614
SHEET NO.	1 OF 1
DRAWN BY	BOB O.
DATE COMP.	9-24-79
SCALE	1" = 200'

OWNERSHIP RECORD										ACQUISITION RECORD				
PARCEL NUMBER	OWNER	DESCRIPTION	TOTAL AREA	AREA REQUIRED: GROSS INCLUDING EXISTING R/W	AREA REQUIRED: NET EXCLUDING EXISTING R/W	EASEMENT AREA	REMAINDER LEFT	REMAINDER RIGHT	SHEET NUMBER	BOARD APPROVAL	TYPE & DATE OF INSTRUMENT	RECORDED DATE	RECORDED BOOK	RECORDED PAGE
~~3-197~~	~~Arizona Title Ins. & Trust Co., Trustee #4508, et al et~~	~~Pt. of SE¼ Sec. 28, T.22 N.R.8 E.~~	~~149.0 Ac.~~	~~3.4 Ac.~~	~~.04 Ac.~~		~~3.0 Ac.~~	~~142.6 Ac.~~	~~1~~					
				Deleted 4-8-80										
3-198	Graves Butane Co. of Arizona, Inc.	Pt. of NE¼ Sec. 28, T.22 N.R.8 E.	1.6 Ac.		.03 Ac.			1.6 Ac.	1	2-28-80	WD 12-19-79	3-21-80	784	835-6

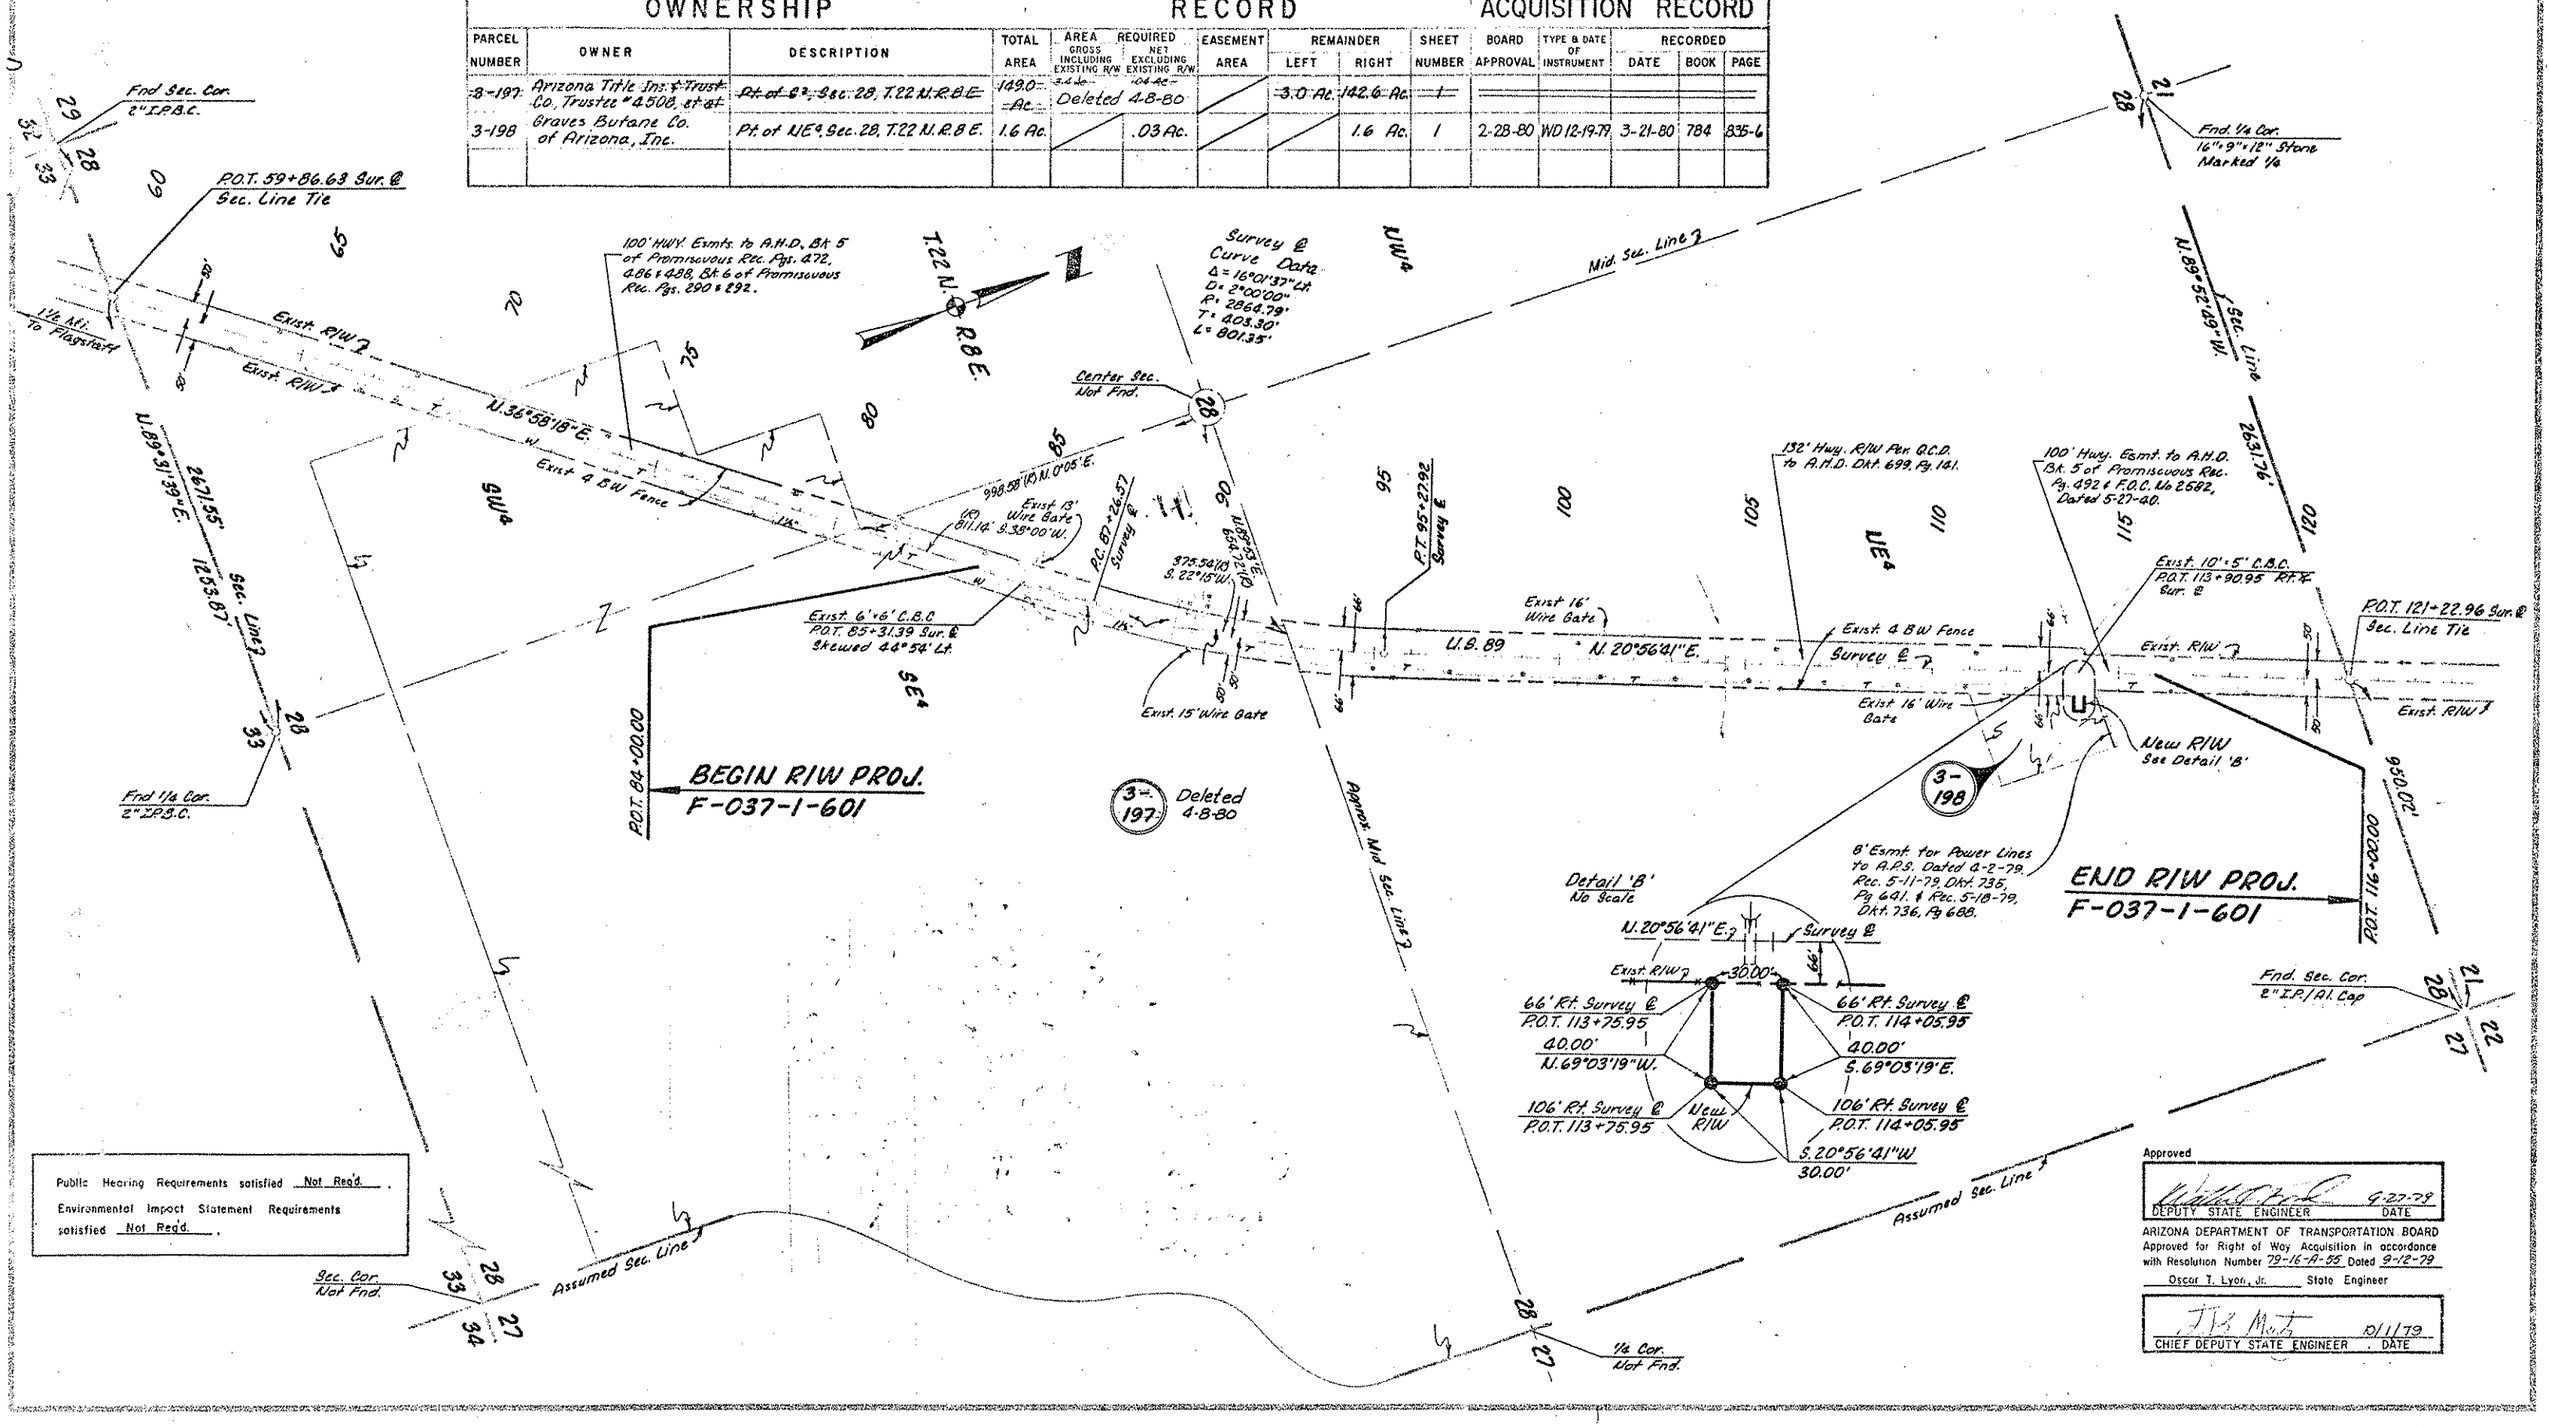

Public Hearing Requirements satisfied Not Req'd.

Environmental Impact Statement Requirements satisfied Not Req'd.

Approved

DEPUTY STATE ENGINEER — DATE 9-27-79

ARIZONA DEPARTMENT OF TRANSPORTATION BOARD
Approved for Right of Way Acquisition in accordance with Resolution Number 79-16-A-55 Dated 9-12-79

Oscar T. Lyon, Jr. State Engineer

CHIEF DEPUTY STATE ENGINEER — DATE 10/1/79