SAN LUIS-YUMA HWY. (U.S.95)
U.S. 95 TRUCK ROUTE (SAN LUIS)
YUMA COUNTY

Click here for US 95 Index

REVISIONS			
C.O. No.	DATE	BY	DESCRIPTION
7094	8-15-85	BAH.D	Changed Areas Parcel 14-415

PROJECT NO.	F-063-1-911
DRAWING NO.	D-14-T-362
SHEET NO.	1 OF 2
DRAWN BY	LFW.
DATE COMP.	3-15-85
SCALE	1" = 50'

HARD COPY, A.D.O.T. SURV. BY T.F. JANCH, 12-4-84 CHECKED BY. M. J. Bowler

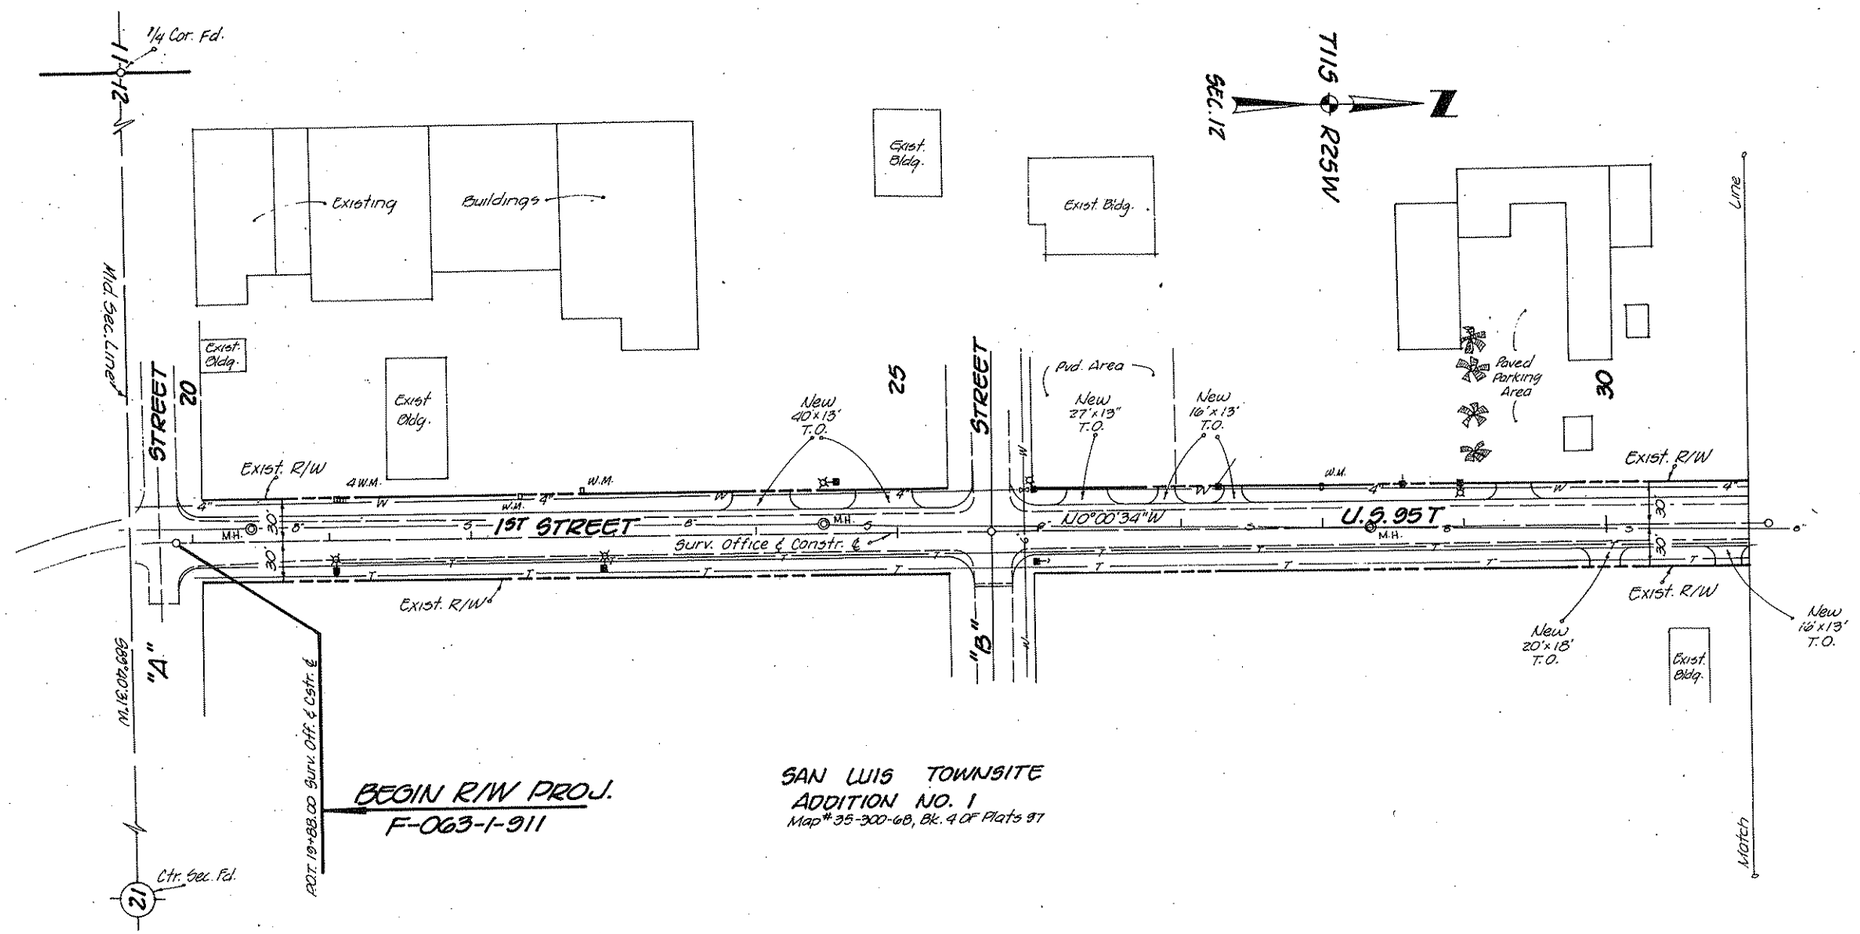

OWNERSHIP RECORD										ACQUISITION RECORD				
PARCEL NUMBER	OWNER	DESCRIPTION	TOTAL AREA	AREA REQUIRED GROSS INCLUDING EXISTING R/W	AREA REQUIRED NET EXCLUDING EXISTING R/W	EASEMENT AREA	REMAINDER LEFT	REMAINDER RIGHT	SHEET NUMBER	BOARD APPROVAL	TYPE & DATE OF INSTRUMENT	RECORDED DATE	RECORDED BOOK	RECORDED PAGE
14-413	Charles Urtuzuastegui et al, Trustees.	Pt. Lots 1, 2 & 3 Block 20, San Luis Townsite Addition #1	59086 ϕ		241 ϕ			58845 ϕ	2					
14-414	Joe Urtuzuastegui	Pt. Lots 1 & 2 Block 21, San Luis Townsite Addition #1	40551 ϕ		194 ϕ		40357 ϕ		2					
14-415	The Incorporated Town Of San Luis Arizona.	Pt. Block 23, San Luis Townsite Addition #1.	~~31676 ϕ~~ 31492 ⊡		~~4606 ϕ~~ 3532 ⊡	~~T.C.E. ONLY 2671 ϕ~~ 208 ⊡	~~400 ϕ~~ 104 ⊡	~~26669 ϕ~~ 27858 ⊡	2					

Public Hearing Requirements Certified 11-2-84
Environmental Clearance 11-2-84

Approved In Accordance With Roadway Plans

DEPUTY STATE ENGINEER DATE

ARIZONA DEPARTMENT OF TRANSPORTATION BOARD
Approved For Right Of Way Acquisition In Accordance With Resolution Number 85-01-A-05 Dated 1-8-85

WALTER D. FORD State Engineer

CHIEF DEPUTY STATE ENGINEER DATE

U.S. DEPARTMENT OF TRANSPORTATION
FEDERAL HIGHWAY ADMINISTRATION

DIVISION ENGINEER DATE

SAN LUIS-YUMA HWY. (U.S. 95)
U. S. 95 TRUCK ROUTE (SAN LUIS)
YUMA COUNTY

REVISIONS			
C.O. No.	DATE	BY	DESCRIPTION
7094	8-15-85	BAH. D	Revised Exit. R/W & Area of Par. 14-415 Rt. US 95.

PROJECT NO.	F-063-1-911
DRAWING NO.	D-14-T-362
SHEET NO.	2 OF 2
DRAWN BY	LFW.
DATE COMP.	3-15-85
SCALE	1" = 50'

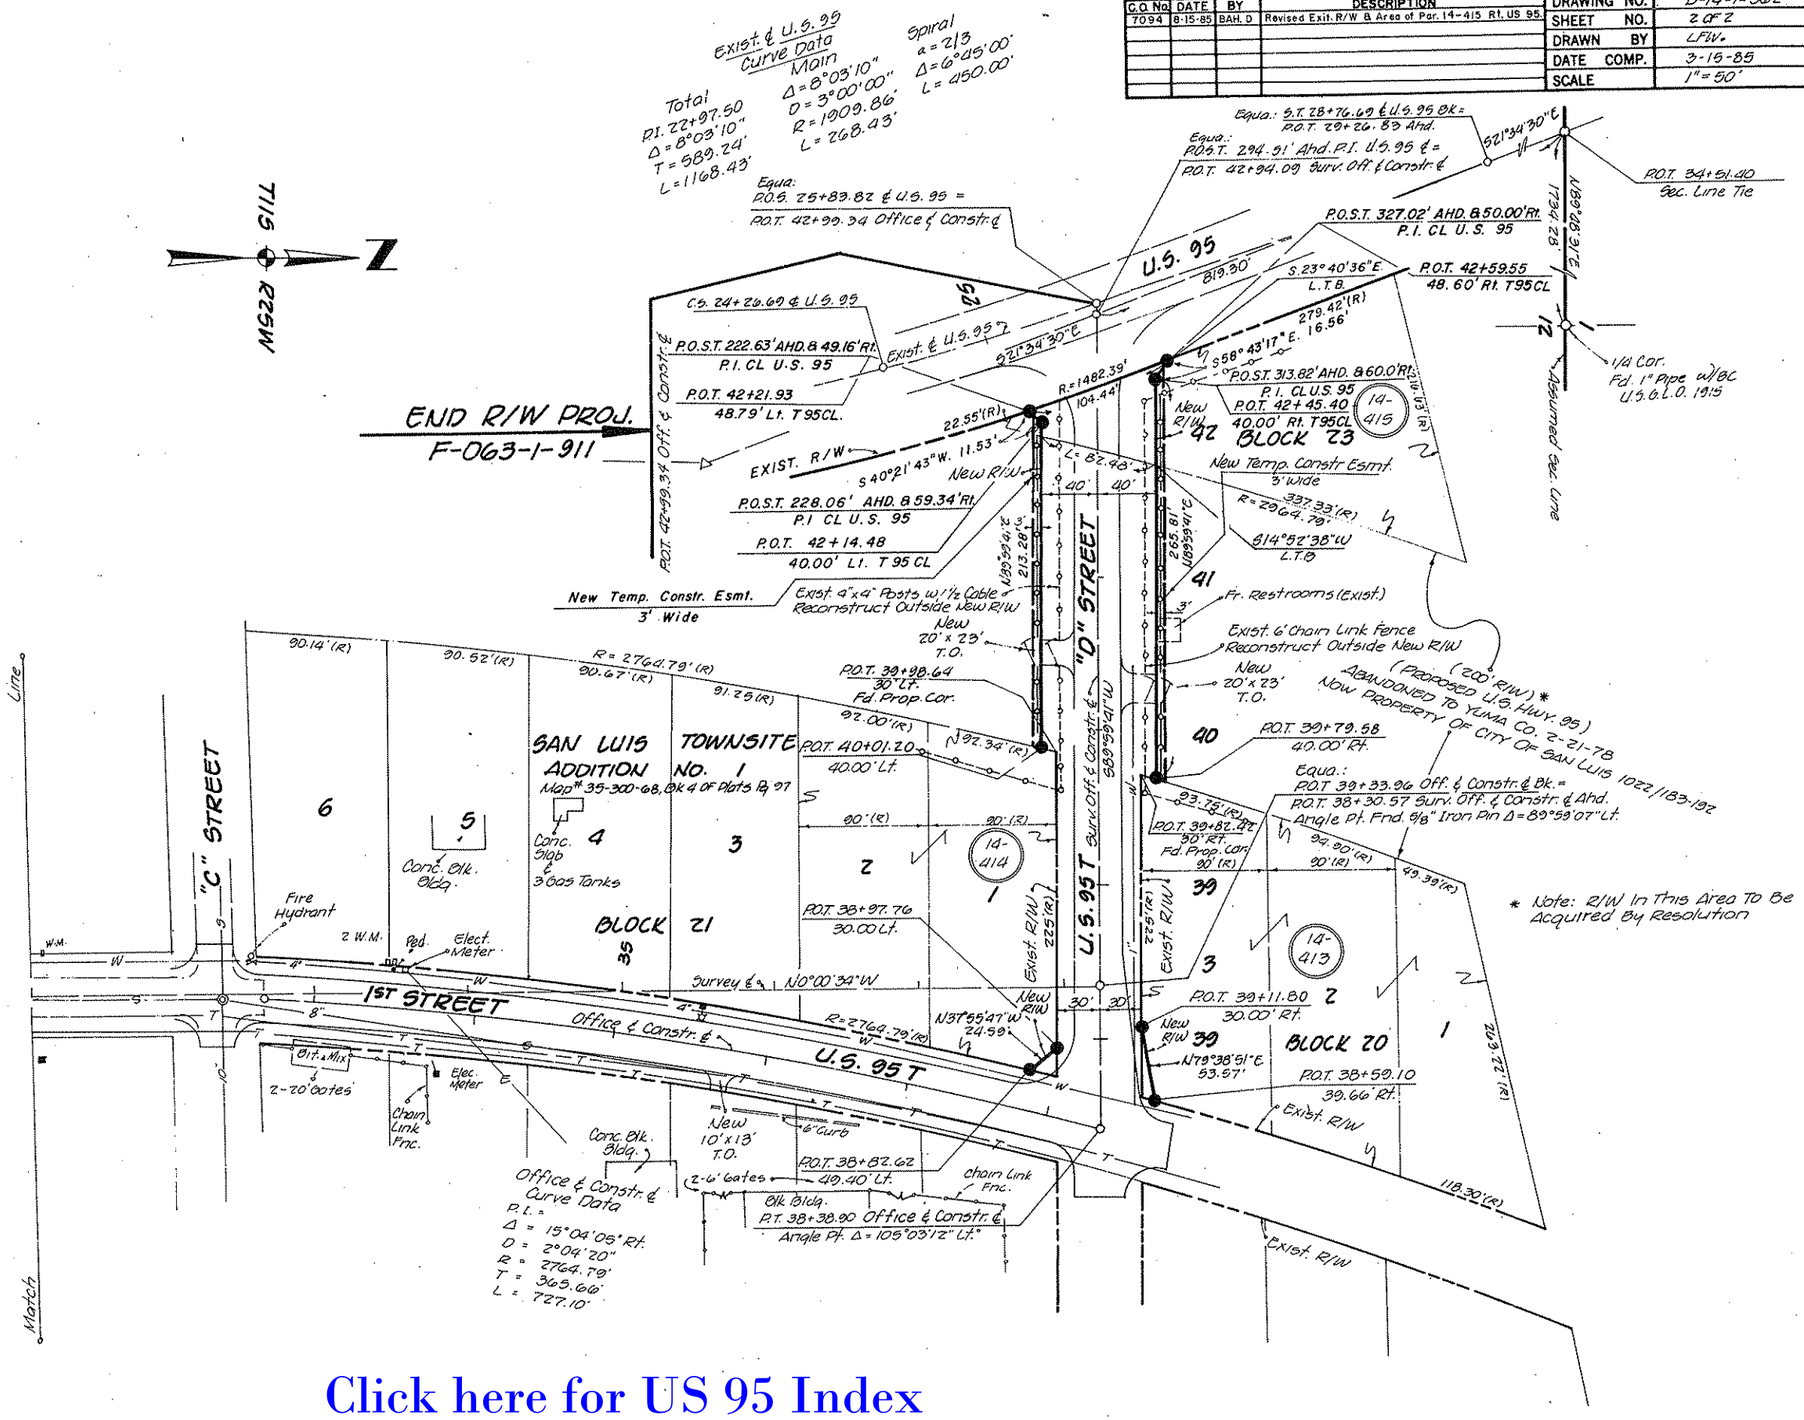

Click here for US 95 Index

HARD COPY. A.D.O.T. SURV. BY T.F. JAUCH 12-4-84 CHECKED BY. M. J. Bradley